



Halverson
Bella


March 29, 1972
clear T=68.

Job # 3535
FINAL & TIES

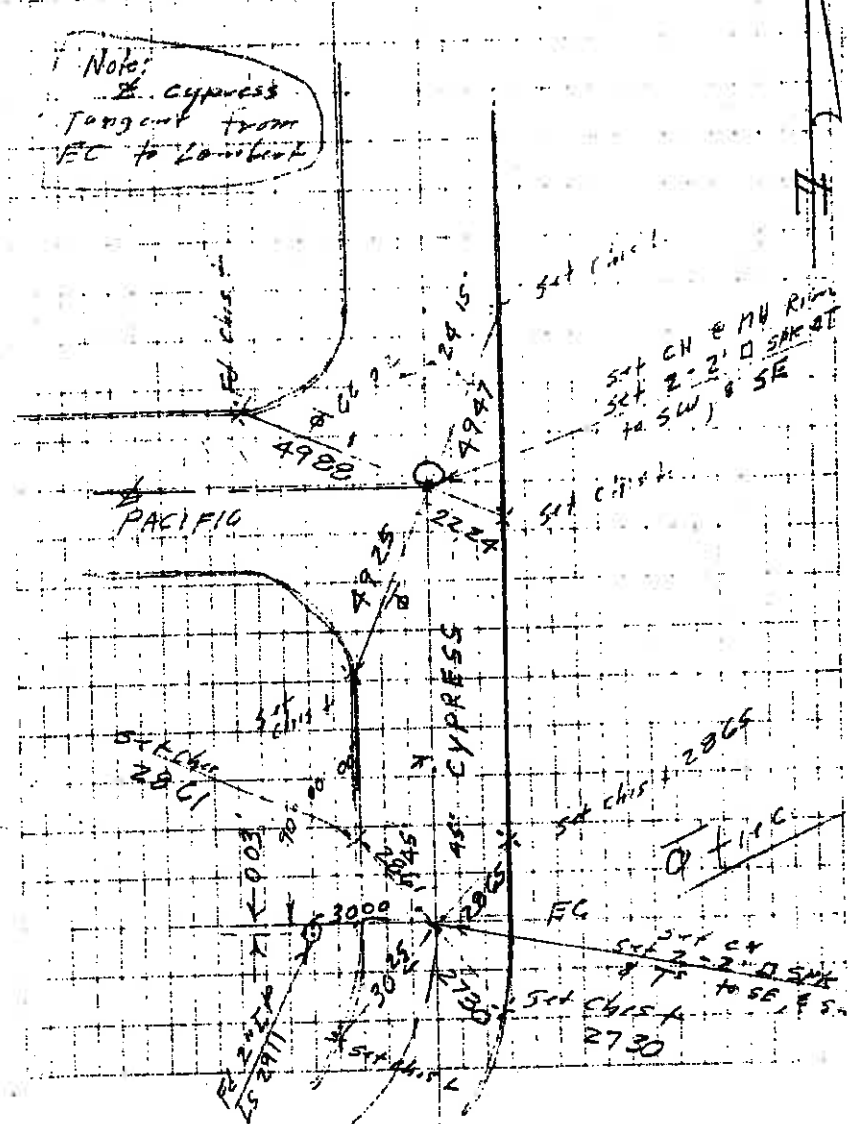

FROM
M.M.-E-3

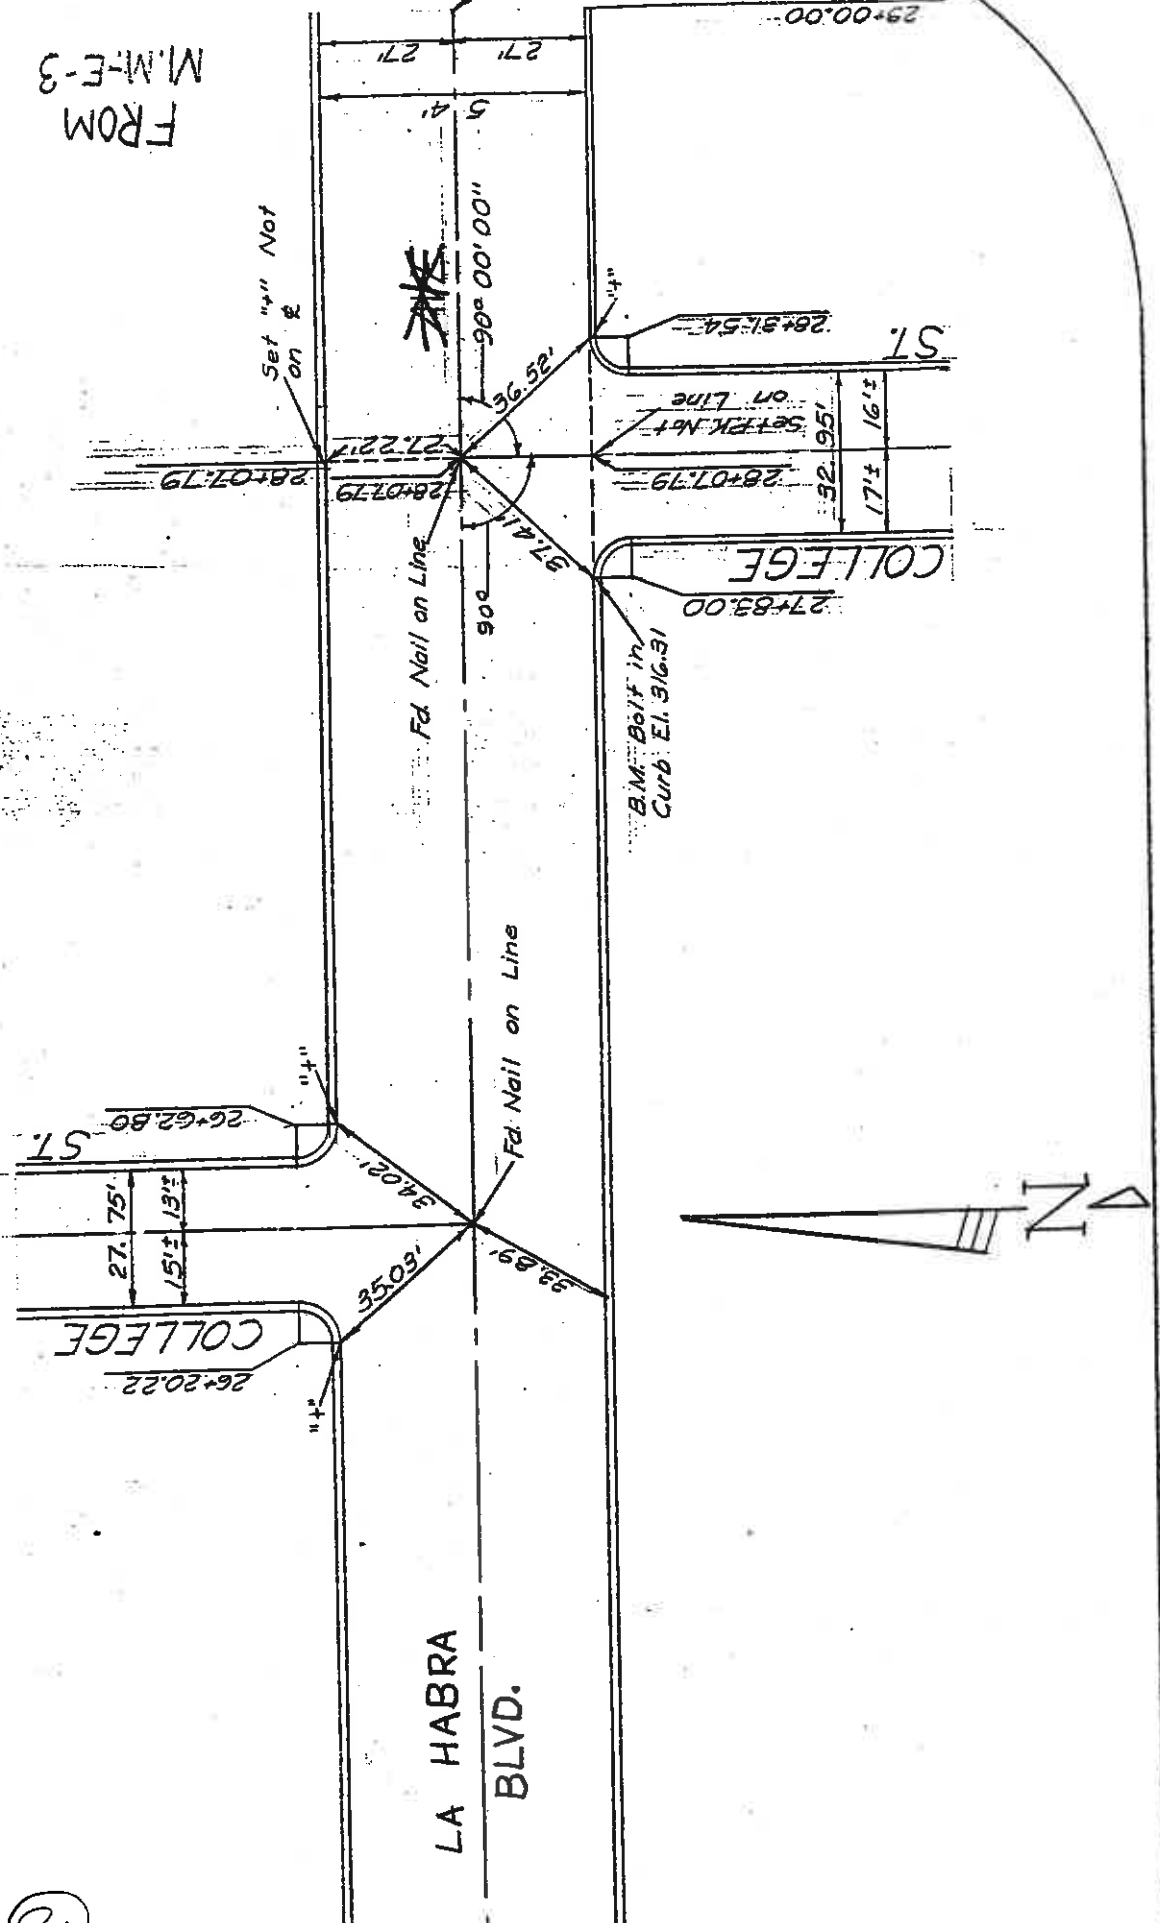


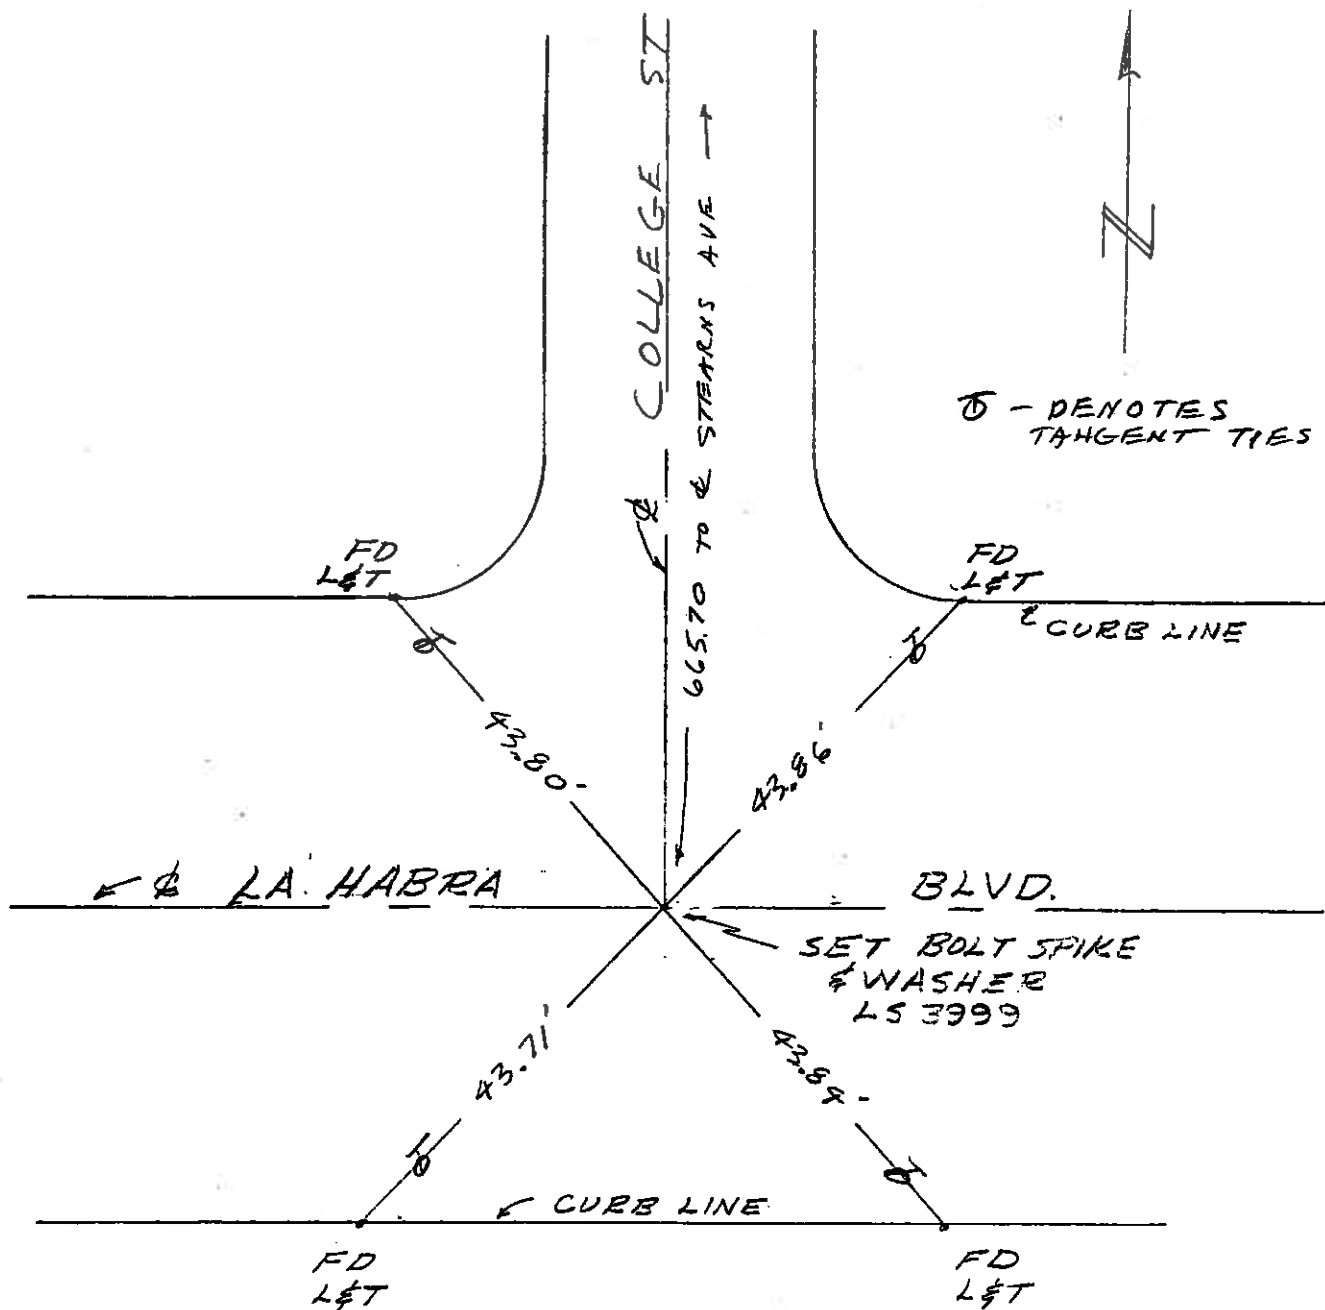



LA HABRA AVE.

CENTERLINE DATA FOR
IMPROVEMENT PLANS IN
THE CITY OF LA HABRA


THOMSEN ENGINEERING, INC.

DEC. 1965 JN. 2550 SCALE 1"=100'

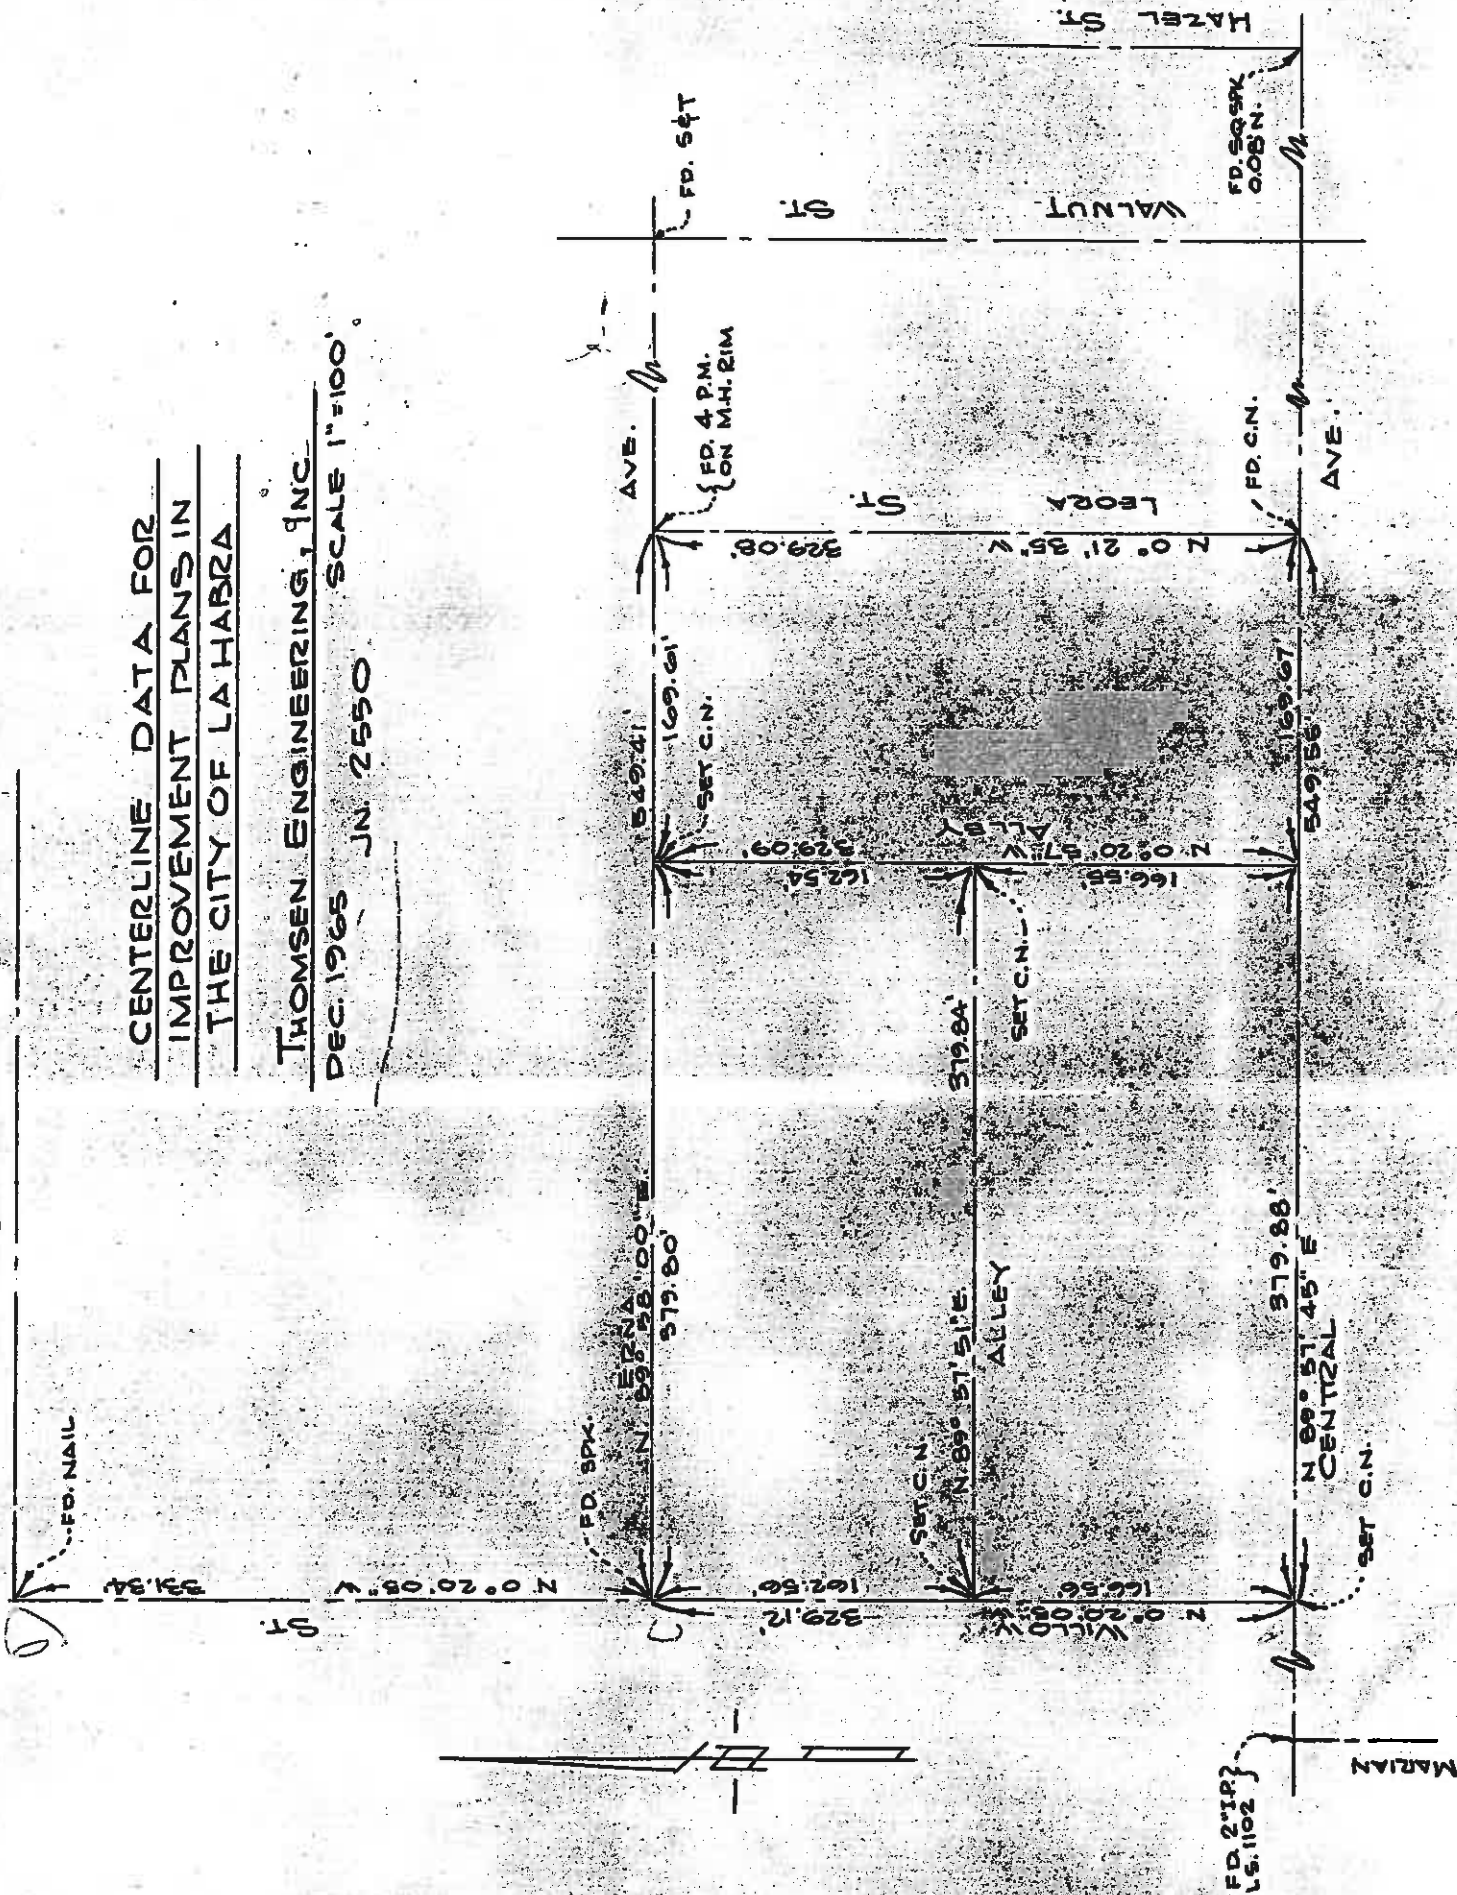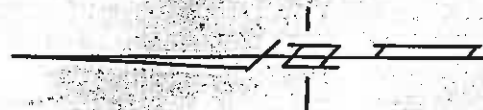

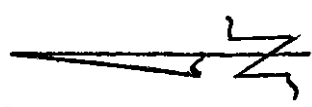

NO SCALE

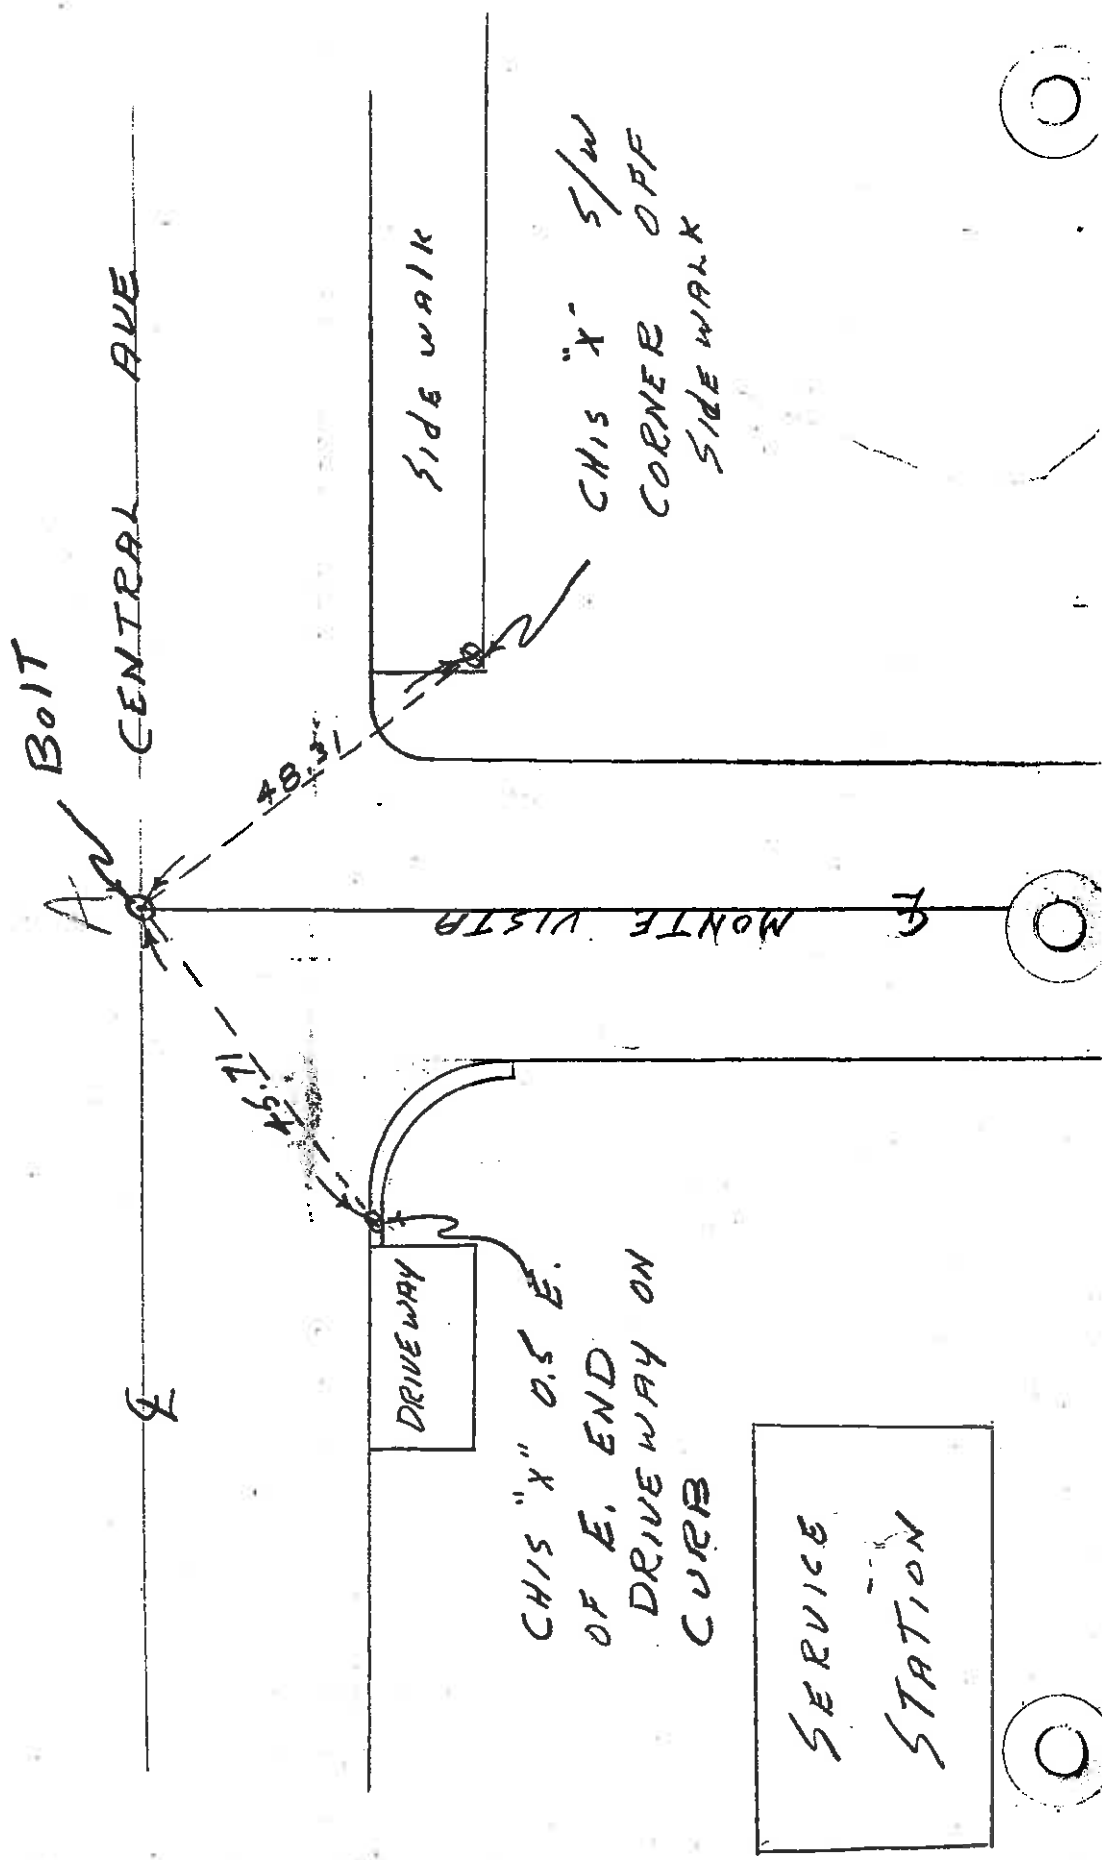

OLSEN SURVEYING SERVICE

sedis
BY LAP02

DATE 3-27-69

SUBJECT

T.I.E.S. to existing points

SHEET NO. 1 OF 2


CHKD. BY

DATE

Construction Ties Only


JOB NO. 10100

No line check made

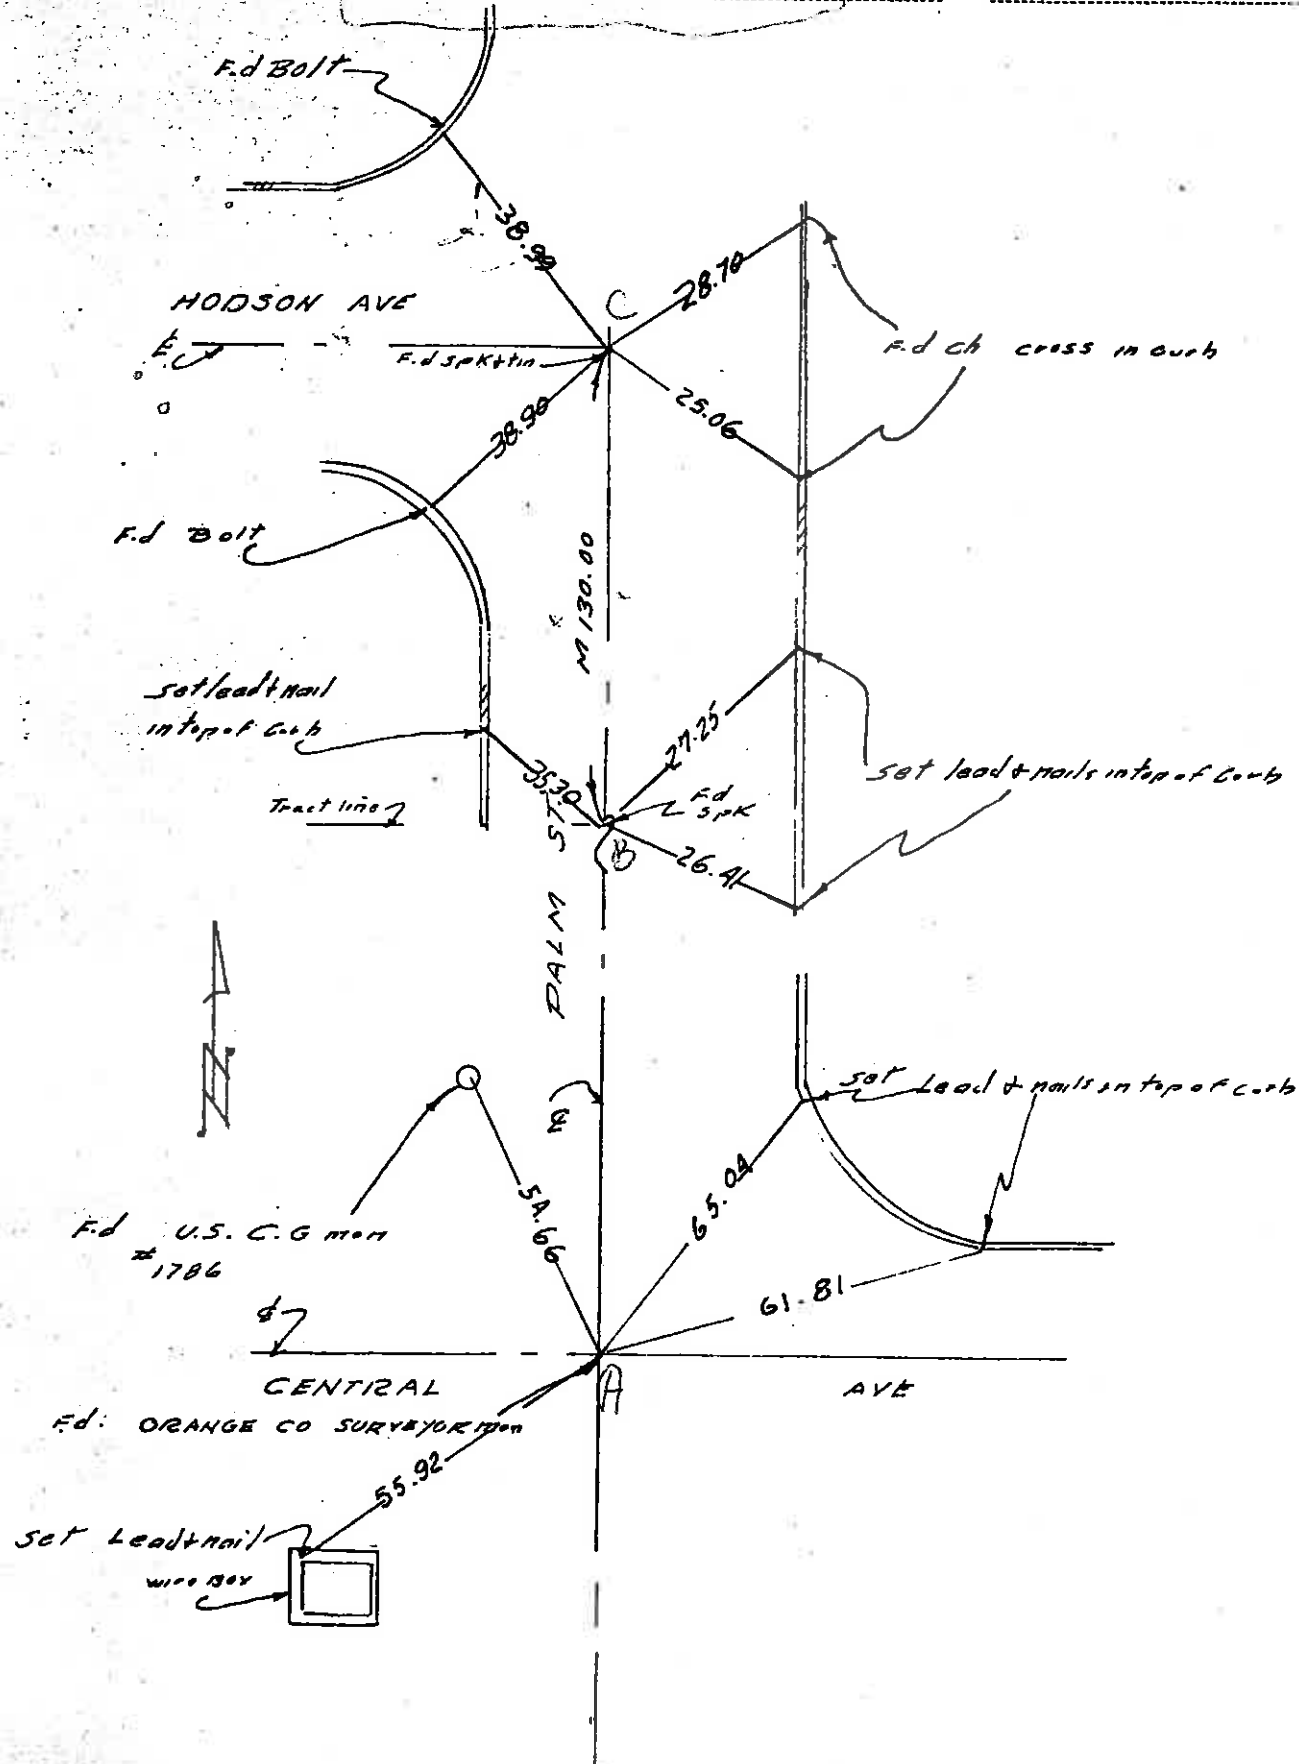

CHARTS
JULY 1967


(12)

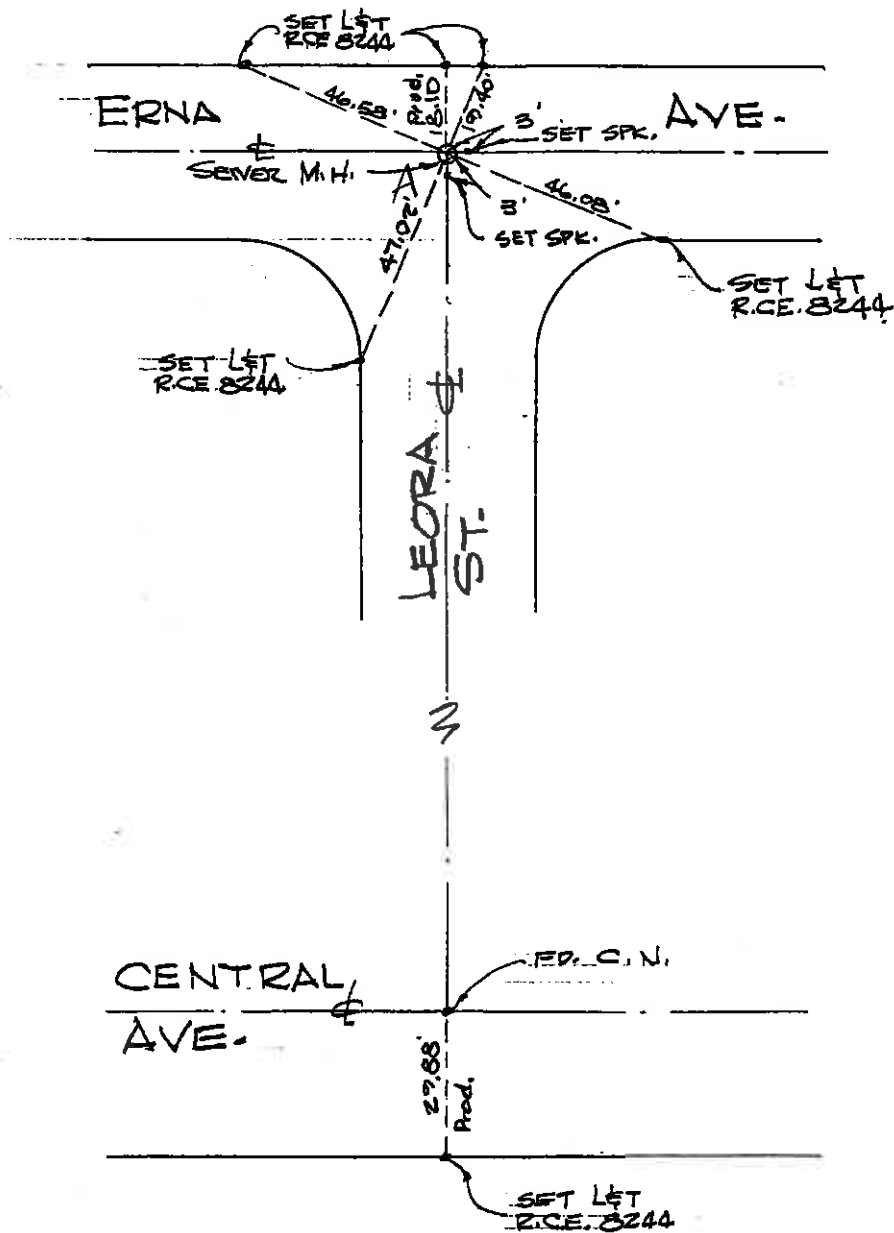

THOMSEN ENGINEERING, INC
16145 E. WHITTIER BLVD.
P.O. Box 1542 Perry Annex
Whittier, Calif. Phone: 691-1111

See pg. 5

08110 M3471, 11/10/1

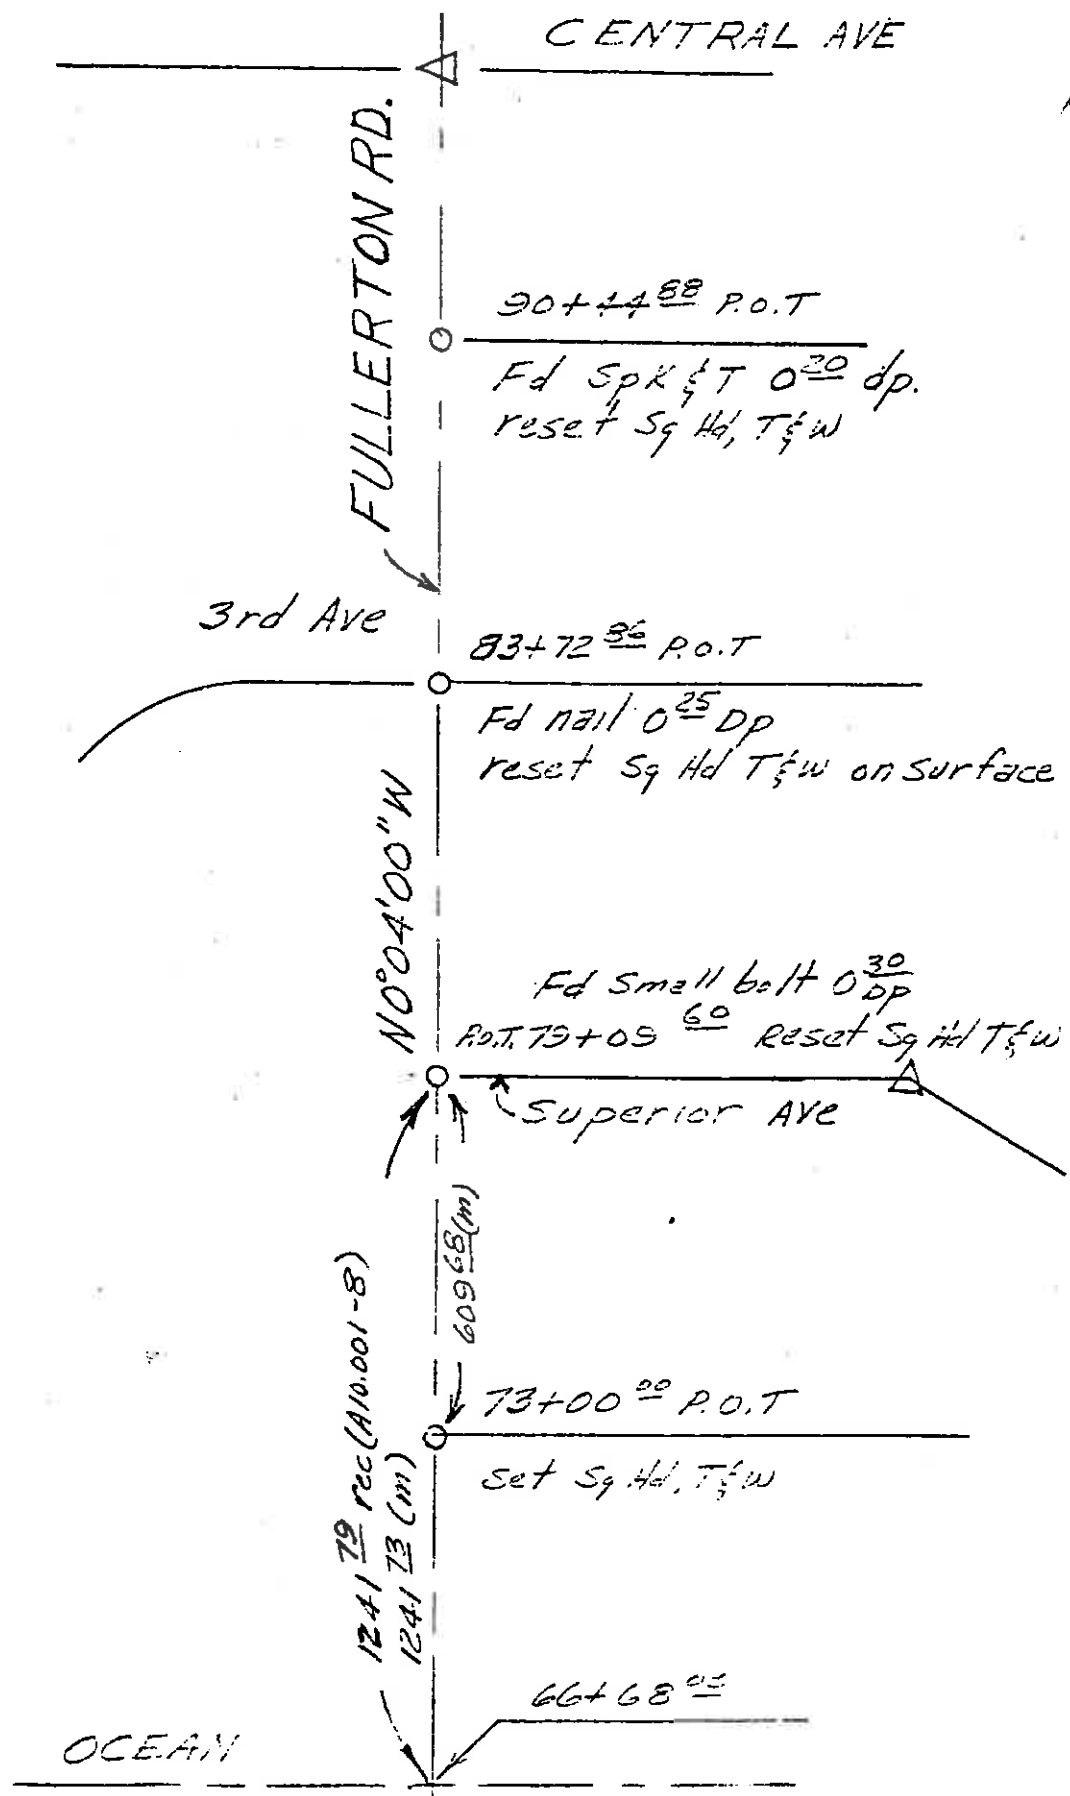

VII

4/60

Kenneth & Phyllis

(10)

See pg. 5

See pg 6

(TM 10.2)

Fd. R.H. & T. 0⁴⁵ Dp.
Set Sq. Spk. T. & W.

FRANCIS AVE.

S 89° 55' 15" W

Nothing Fd.
Nothing Set

± FRANCIS AVE
N 89° 57' 56" E

107+65⁴⁶ Fullerton Rd.
10+00 Francis Ave

± KERNER WAY
S 89° 57' 25" W
Nothing Fd.
Nothing Set

102+67⁶² P.O.T.
Fd. C. Spk. & W. 0³⁰ Dp.
Set Sq. Spk. T. & W.

± LA HABRA AVE.
S 89° 55' 55" W

Nothing Fd.
Nothing Set

96+50³⁰ Fullerton Rd.
10+00 ERNA ST.
Fd. C.N. 0²² Dp. (TM 10.2)

Set Sq. Spk. T. & W.

± ERNA ST.
N 89° 54' 39" E

FULLERTON RD.

N 00° 01' 00" E

93+00⁰⁸ BK=
93+09²⁰ Ahd Fullerton.

Fd. Spk 0³⁵ Dp.
(TM 10.2)

Set Sq. Spk. T. & W.

S 89° 57' 41" W

± CENTRAL AVE.
N 89° 54' 41" W

10+00 Central Ave

N 00° 01' 00" E

B6478 M69-79.89

N

APRIL 1960


KESWICK & PTV

OK 72 7.2/11.9
 07212- 230231
 54 2-217

TIES @ Whittier Blvd.
 and Chantry Drive



6-23-70 WARM white/
 Adams & Pty

24

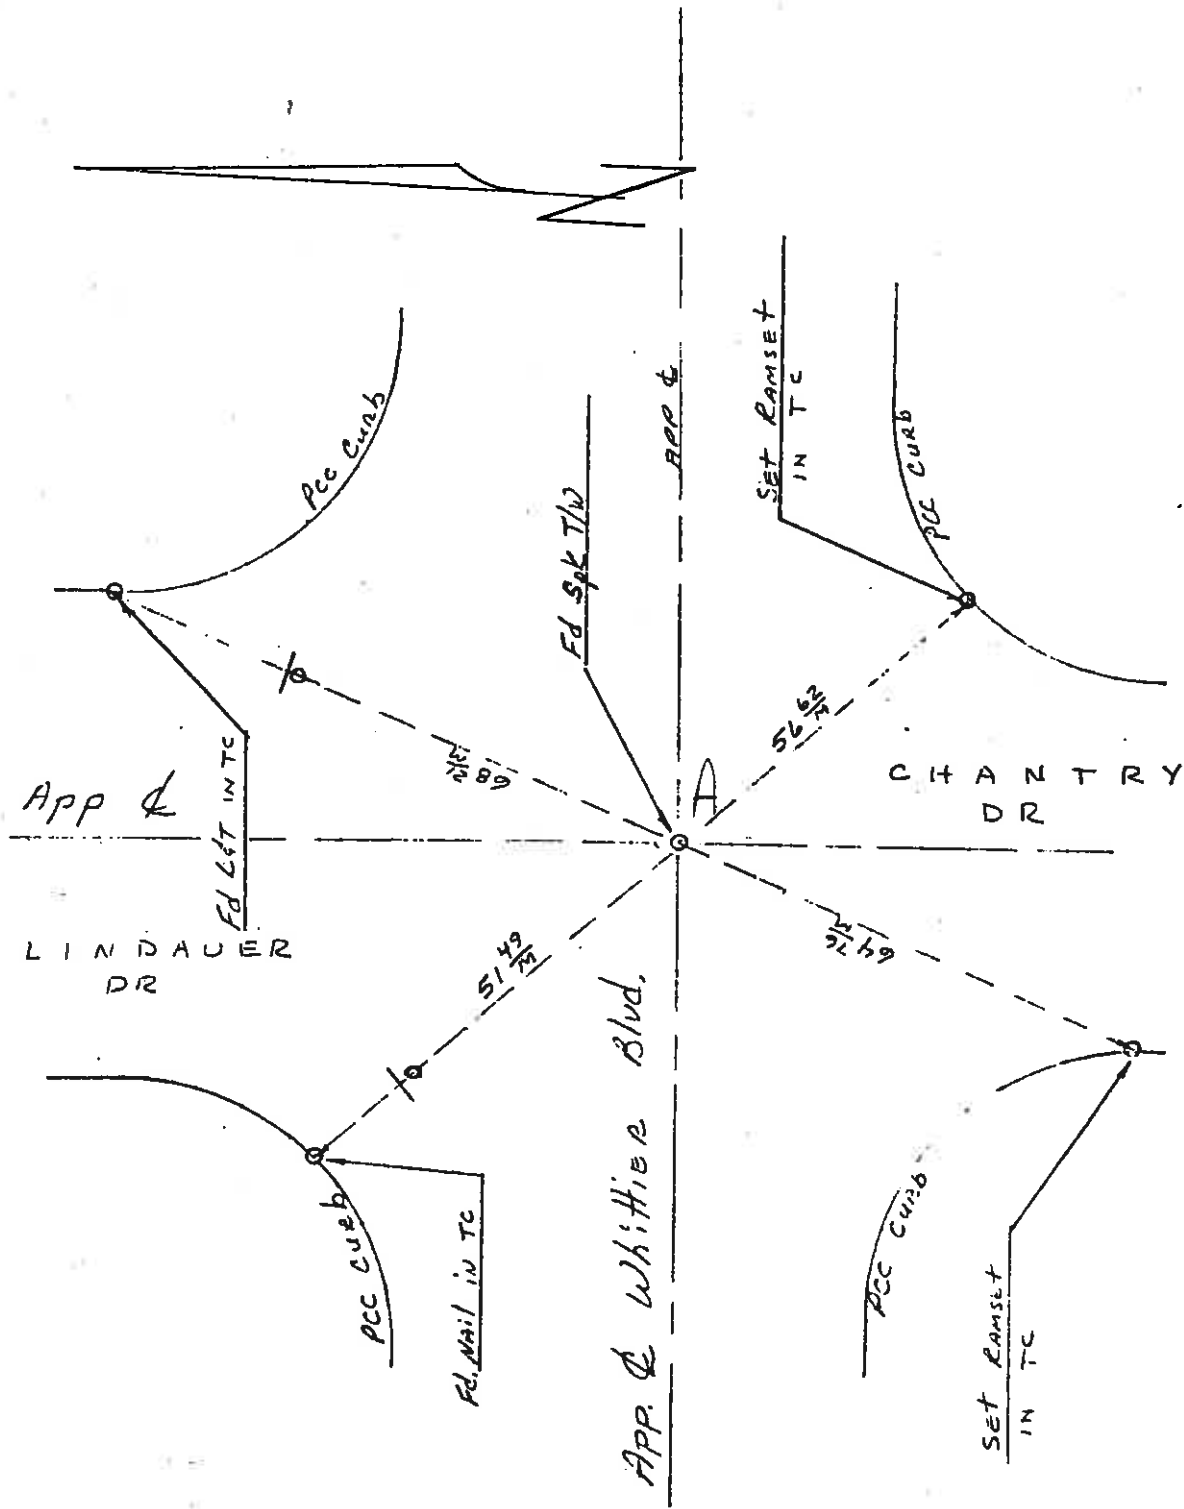

see pg 7

156448 M96,97,98-

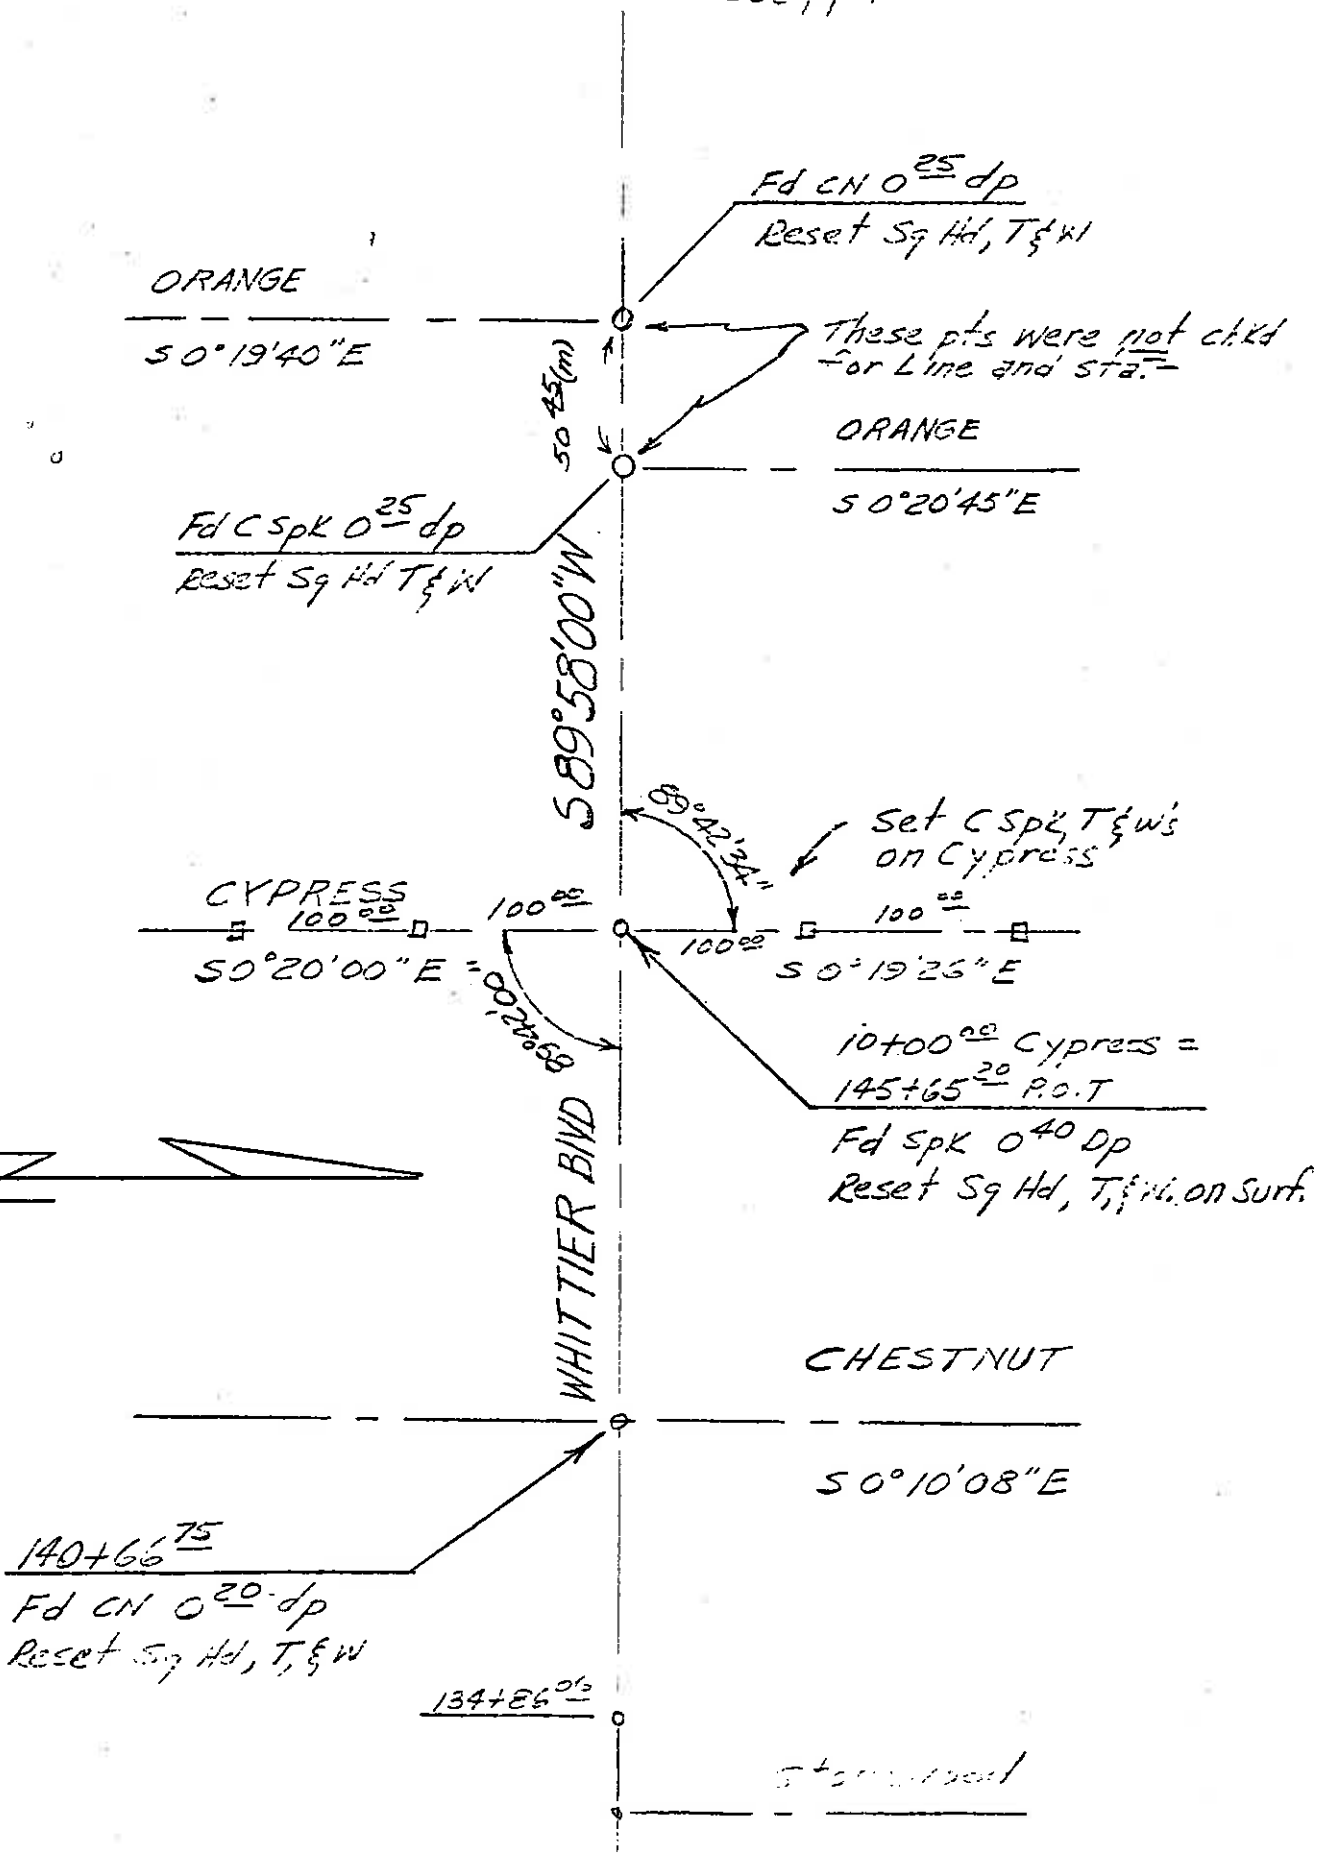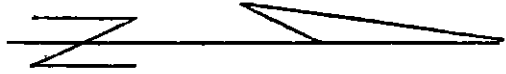

111

4/60

Resurvey of Hwy

(7)

see pg 7

TO IDAHO

See bottom pg. 11

191+00 ⁶² P.O.TFd & CN straddlers 0³² dp.
reset Sg Hd, T, & W

CITRUS

50°04'00"

MONTE VISTA

S 0°12'15" E

184+42 ⁹² P.O.T.Fd Sg Spk 0²⁵ dp
Reset Sg Hd, T & W.58°58'00" W
WHITTIER BLVD173+27 ³³ P.O.T. AND =173+06 ³² P.O.T. EX
Nothing Fd, nothing set

C Spk T & W

WALNUT

200⁰⁰

50°20'00" E

90°18'00"
(m)100⁰⁰C Spk
T & W

50°19'15" E

100⁰⁰

C Spk, T & W

172+06 ⁸¹ P.O.T.Fd Spk T & W 0⁴² dp
Reset Sg Hd, T & W.

HAZEL

50°19'00" E

Fd LS TAG 0²⁰ dp.reset Sg Hd, T & W on Surf
NOT CHKD FOR LINE
& STA.

See top of p. 11

VIII

4/60

Resurvey & Plan


(4)

ORA 72 9.2/11.9
07212
260-231
SUR REQ # 70-217

TIES @ WHITTIER BLVD
AND CHESTNUT ST.

6/24/70
R. ADAMS & FRY

20 24
J. WALDROFF

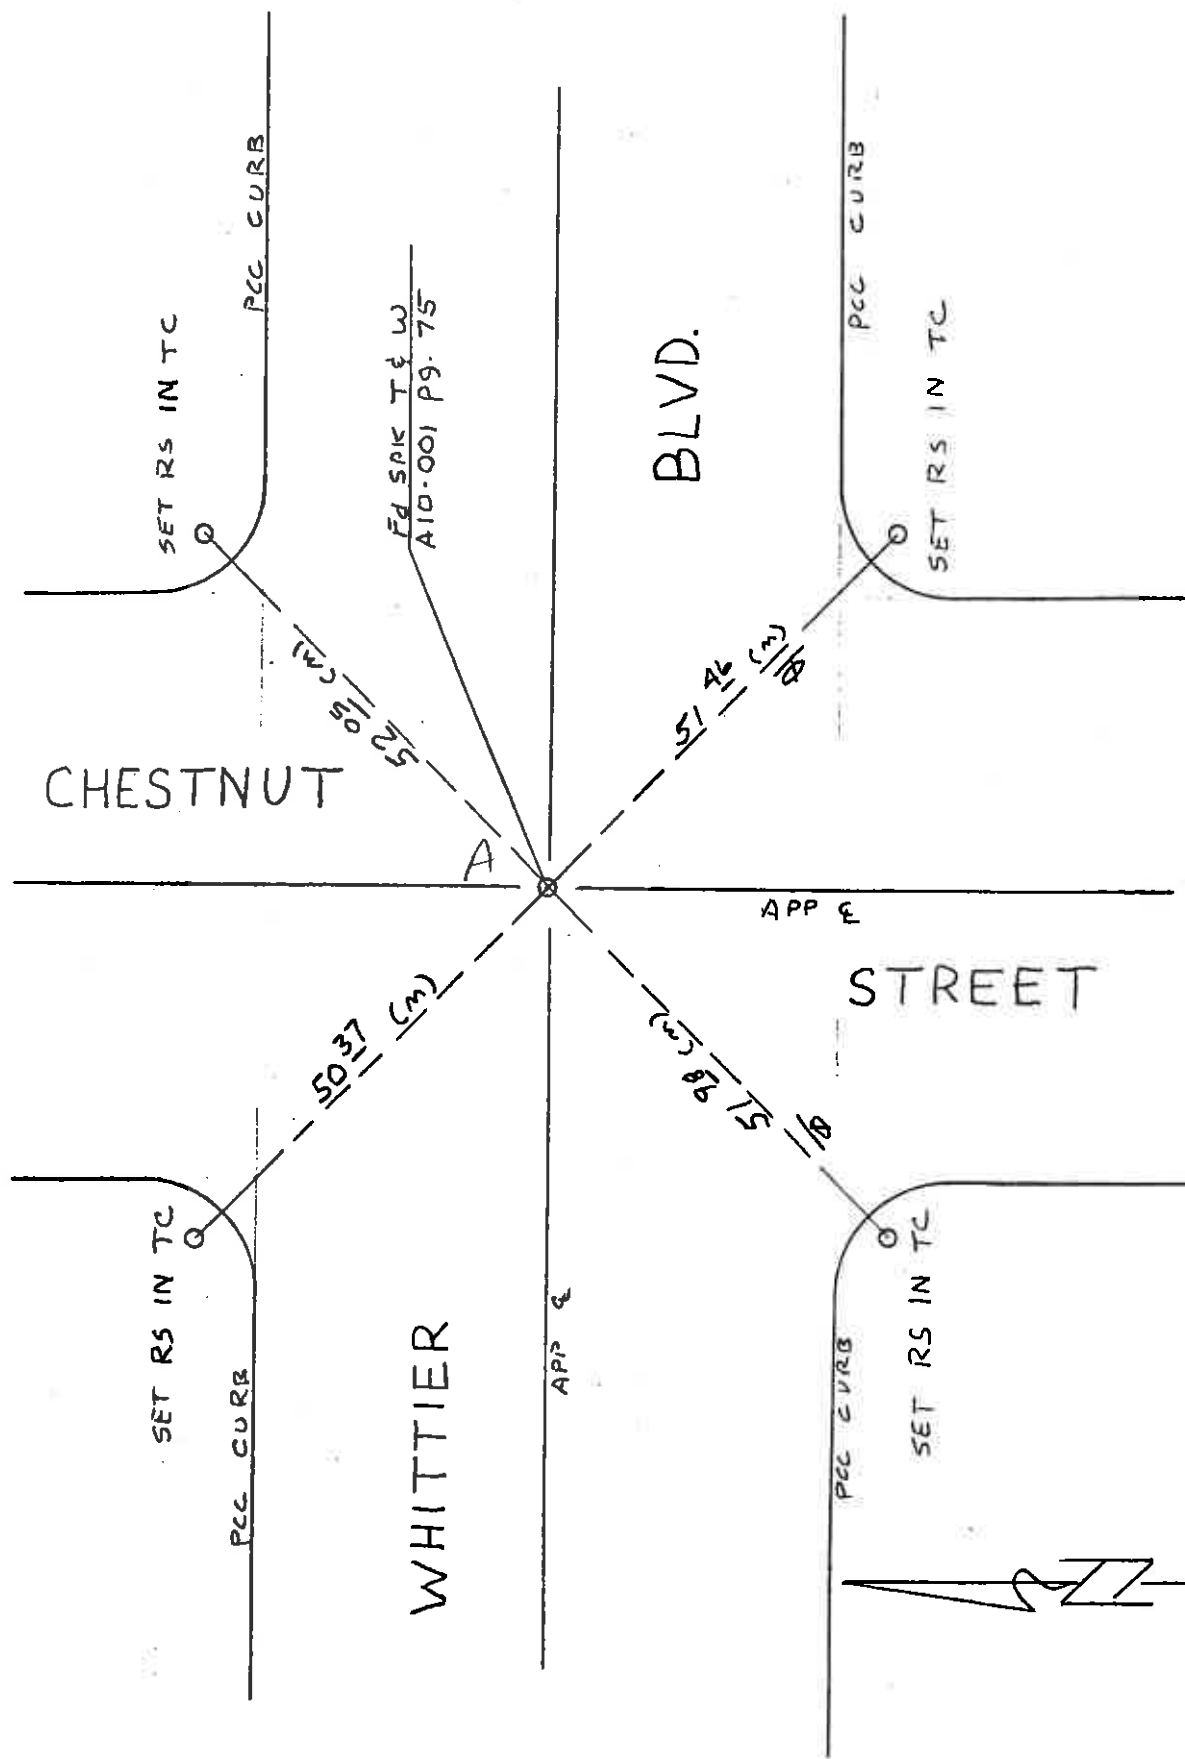

ORA 72 75/11.4
35743M

WHITTIER BLVD TIES PRIOR TO
RESURFACING

4.21-78
WINTER


PW

36

BLK 6448 MOD 97

REF. A10.001-6.75
A080720-22

78-066

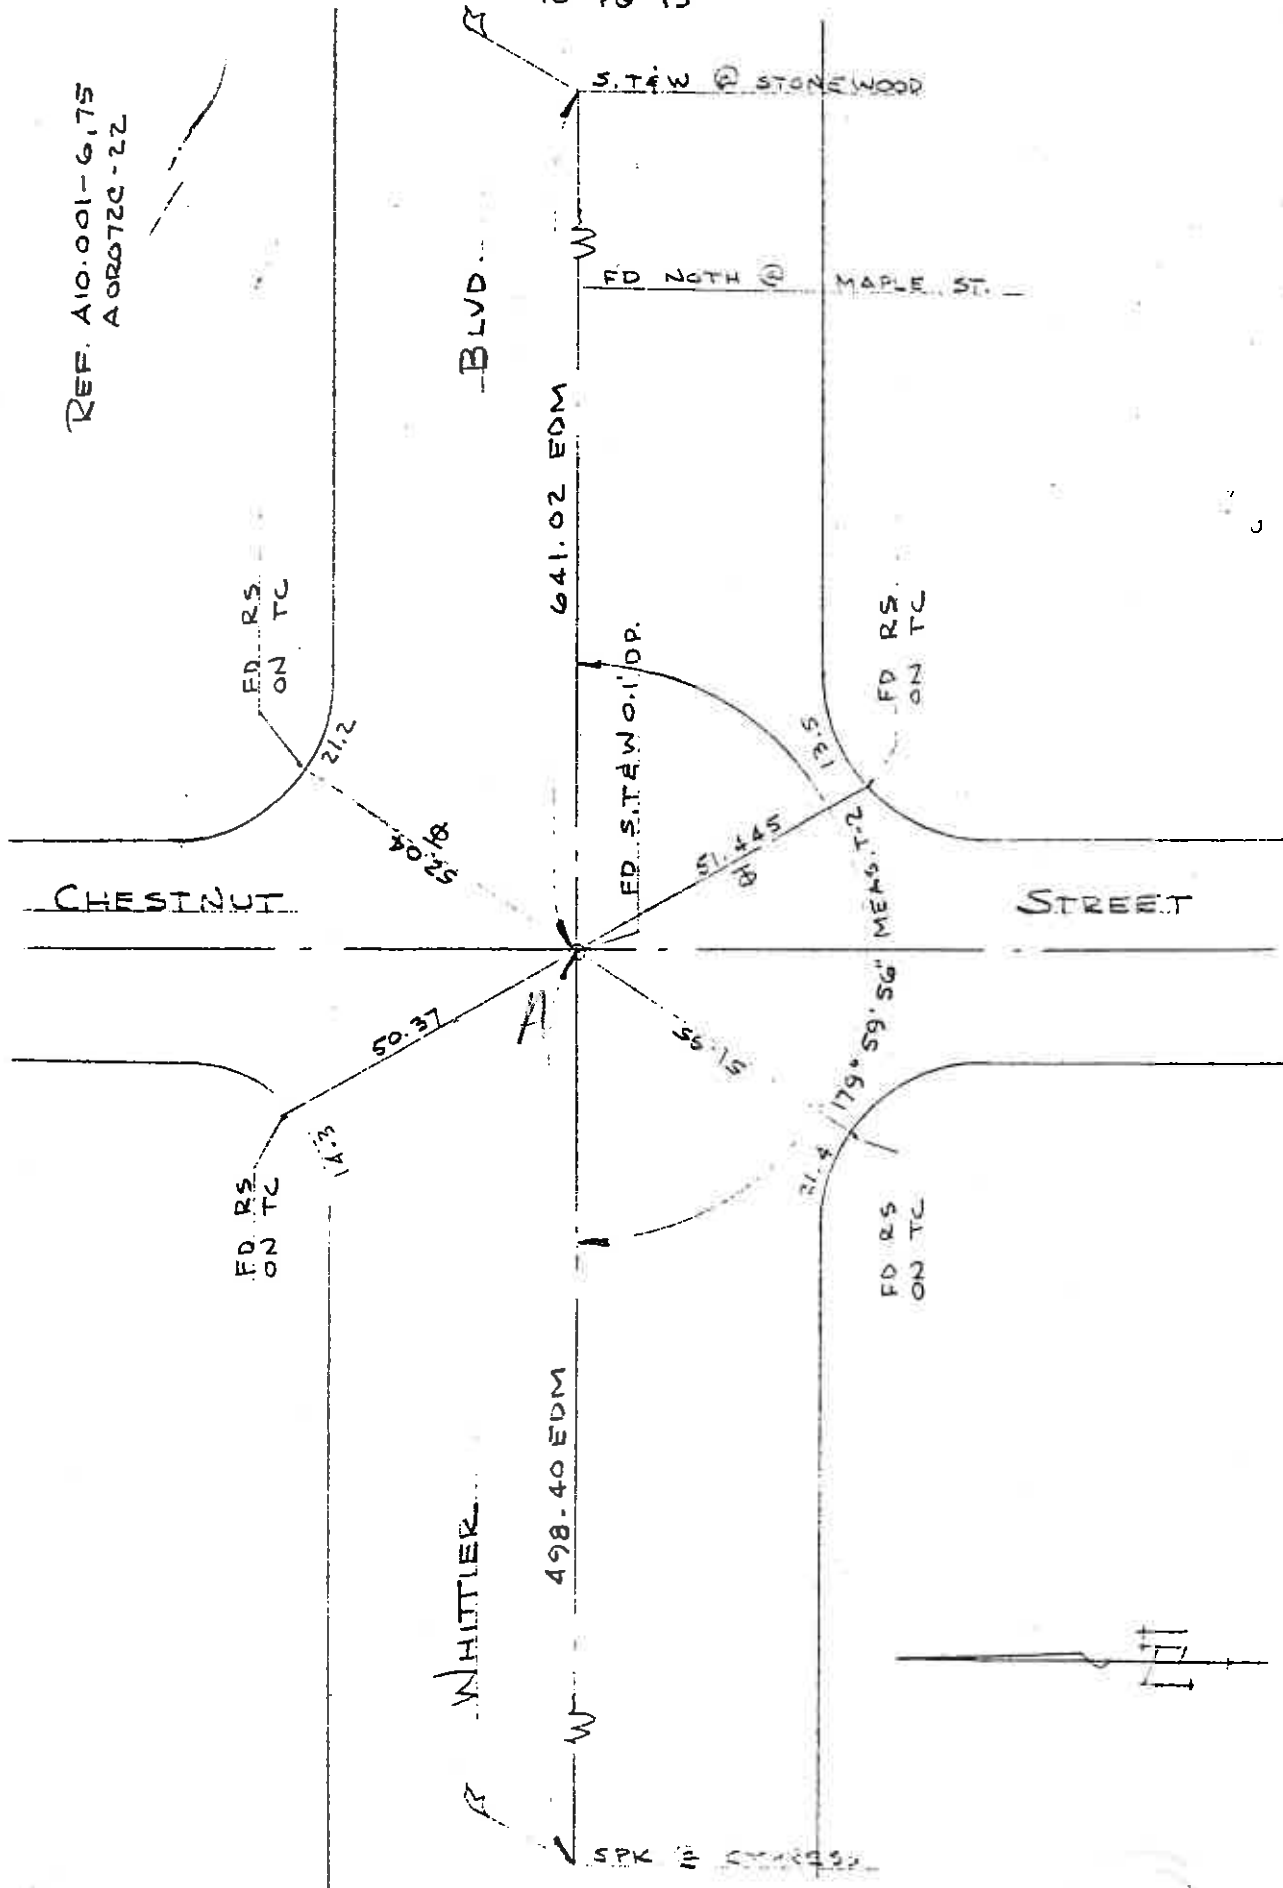

TO PG 13


C014

SEA 72 9.2/11.9
07010-260231
51-257-70-217

TIES
WHITTIER BLVD &
CITRUS D.R.

6-23-70
ADAMS & PTY

11 24
SULIS

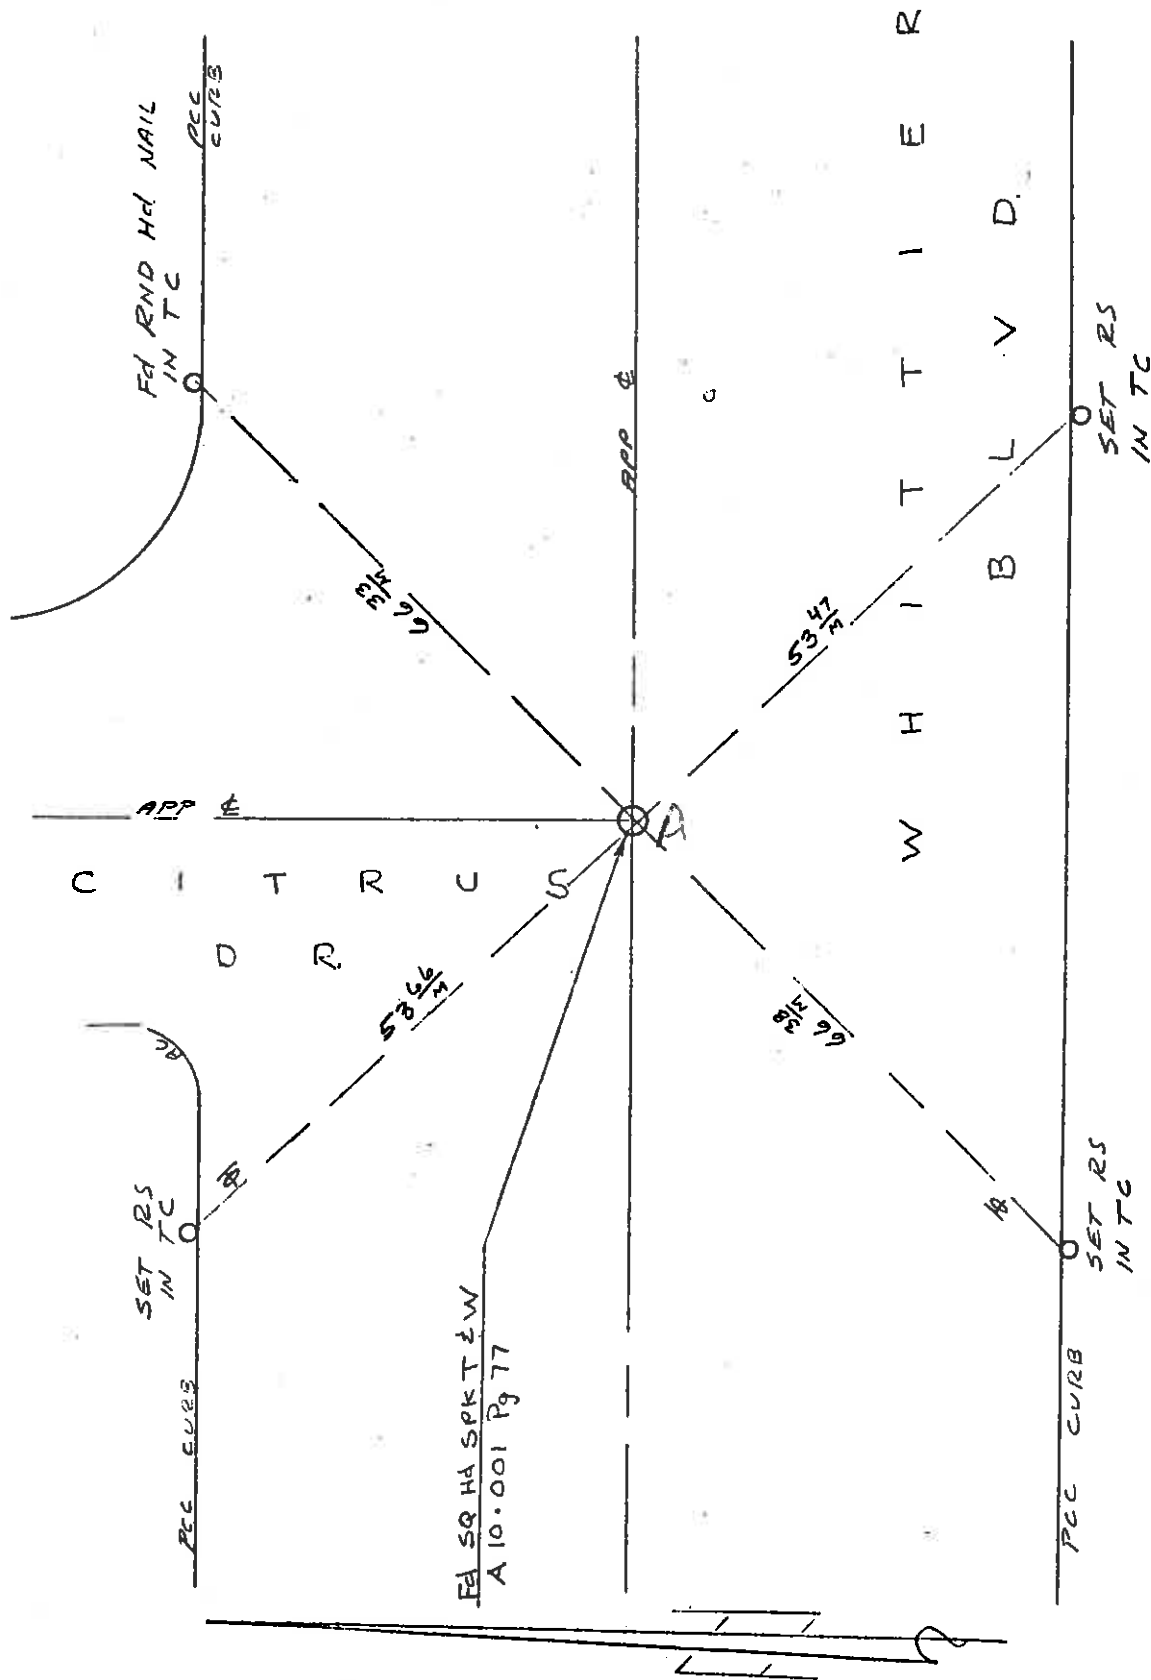

AOR 072C

0013

OKA T2 7.5/11.4
35143M

WHITTIER BLVD. TIES PRIOR TO
RESURFACING

4-19-78
WINTER

PW

5 36

M/G 4.21

BLK 6448 MOD 92

REF A10.001-3,17
A00720-13

CITRUS
DRIVE

SET "SHURE SET"
ON TC

FD RS.
ON TC

WHITTIER

BLVD

25.99

54.77 M

657.36 EDM

657.69 EDM

FD S, T, W
0.1' DP.

53.45
8.45

82.99

FD RS.
ON TC

FD RS.
ON TC

179° 59' 58" MEAS. T.2

0005

78-066

TO 26 4

TO 26
S, T, W
MONTE VISTA

TO 26 4


ROBERT WADA & ASSOCIATES

699 SO. STATE COLLEGE BLVD., SUITE E, FULLERTON, CA 92631
(714) 992-5461

ROBERT M. WADA
LS 3090

CREW L. SUZUKI
G. NEWTON
G. NEGULESCU

JOB. NO. 1110
DATE 3-31-88
PAGE 1 OF 2

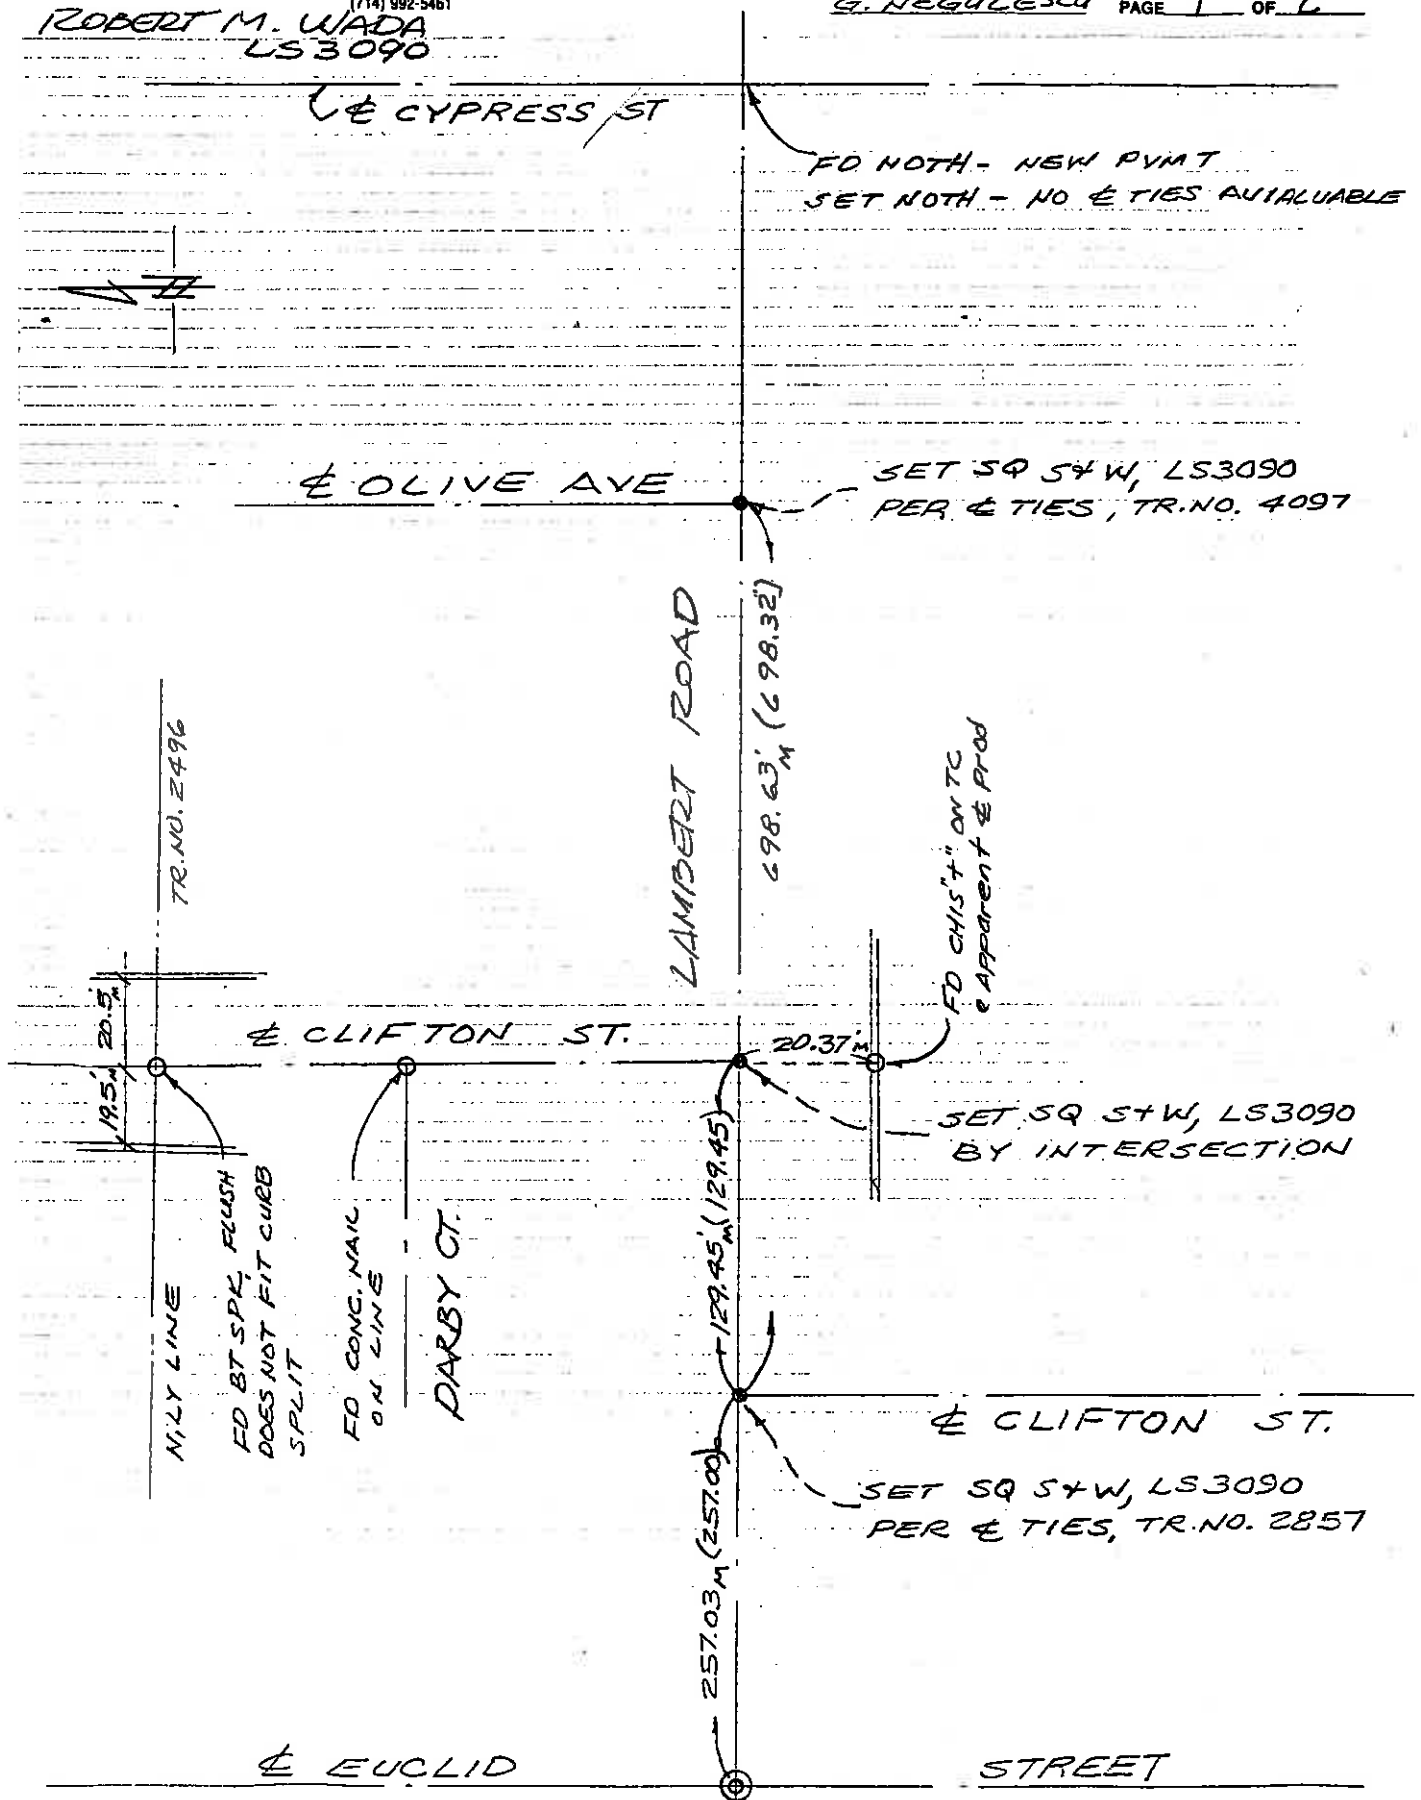

E TIES - RE-SET INTERSECTIONS

OLIVE AVE & LAMBERT RD.

CLIFTON ST & LAMBERT RD - 2 INTERSECTIONS

CITY OF LA HABRA


ROBERT WADA & ASSOCIATES

699 SO. STATE COLLEGE BLVD., SUITE E, FULLERTON, CA 92631
(714) 992-5461

CREW T. SUZUKI
G. NEWTON
G. NEGULESCU

JOB. NO. 1715
DATE 3-31-88
PAGE 2 OF 2


ROBERT M. WADA
LS 3090

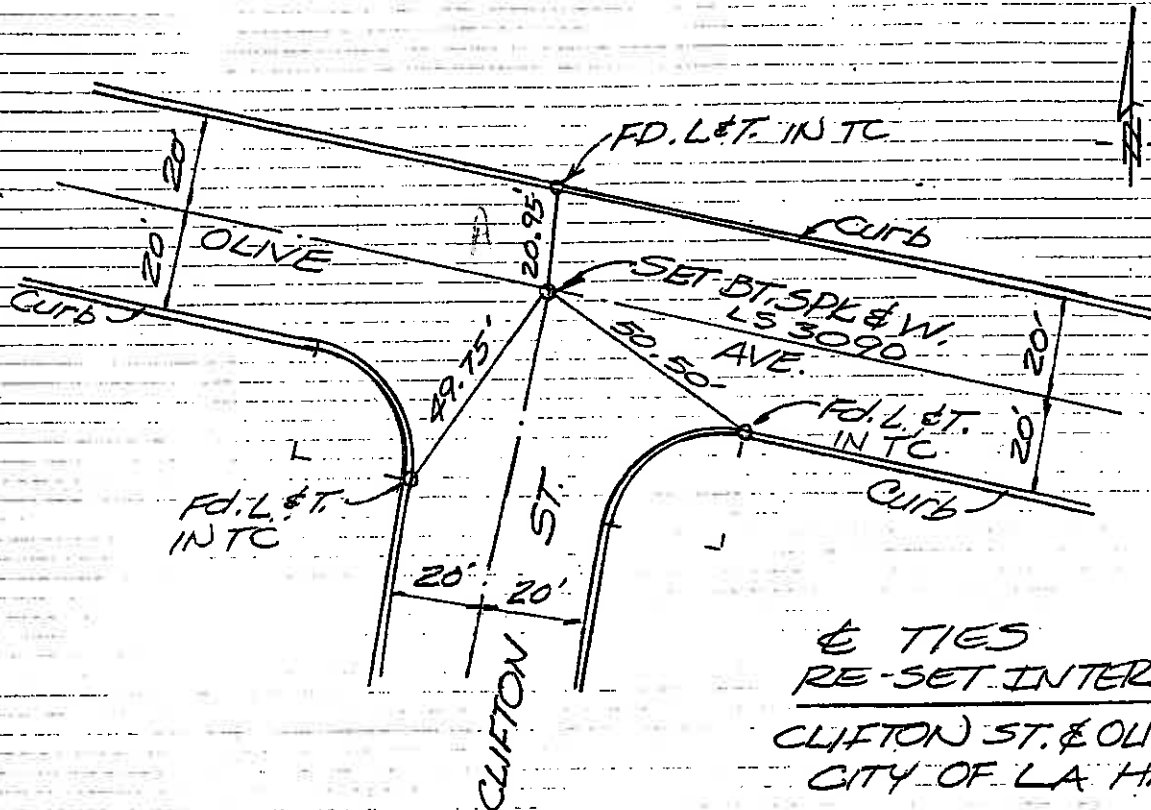

F. B. _____ Pg. _____ SURVEY OF STERNS AV - COLFAX ST.

TR. No. _____ SURVEY BY ROBERT WADA & ASSOC

DATE 7-22-88 JN 1722

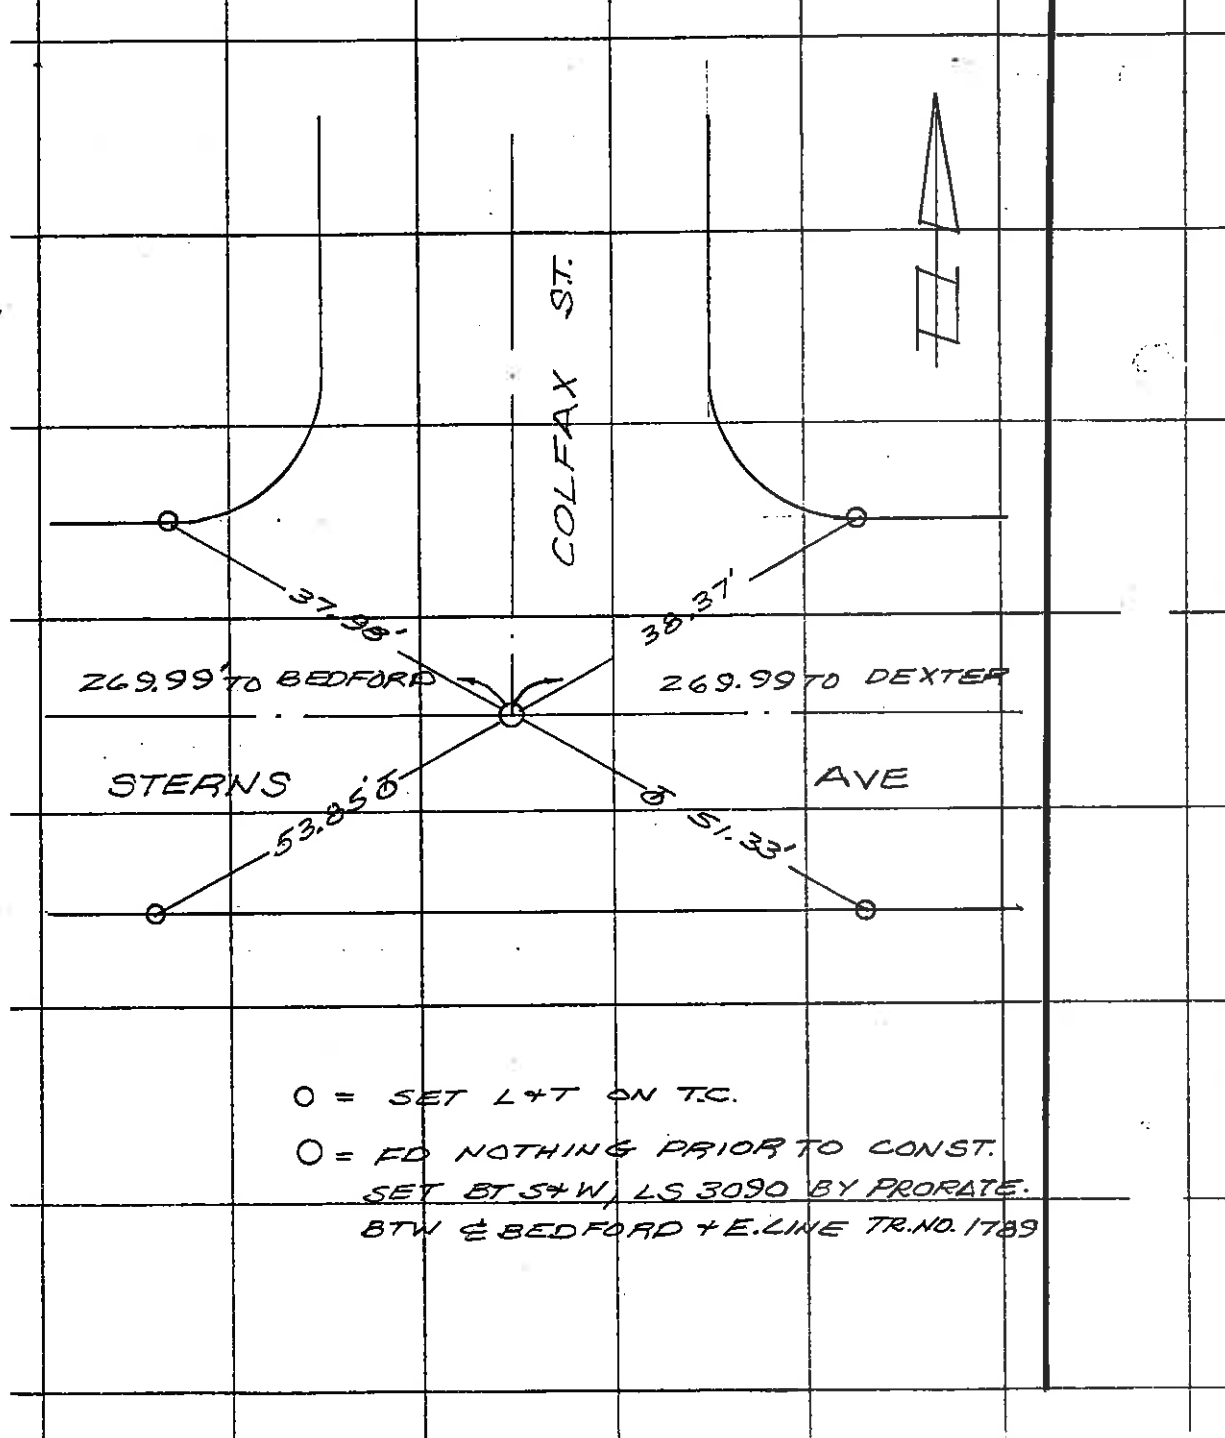



SET. BT. SPK. &
WASHER
2+63.06

AVE.

VALENCIA ST.

FRANCIS

* = SET L & T.

FD. CHIS " + " IN CONC.
GUTT. 0+00 E'LY

± 1' NO. OF B.C.R.


± 1' SO. OF B.C.R.


COLLEGE

ST.

SET IN CONC. WK. ON E PROD.


JUDKINS, AGUILAR DATE 7-31-81

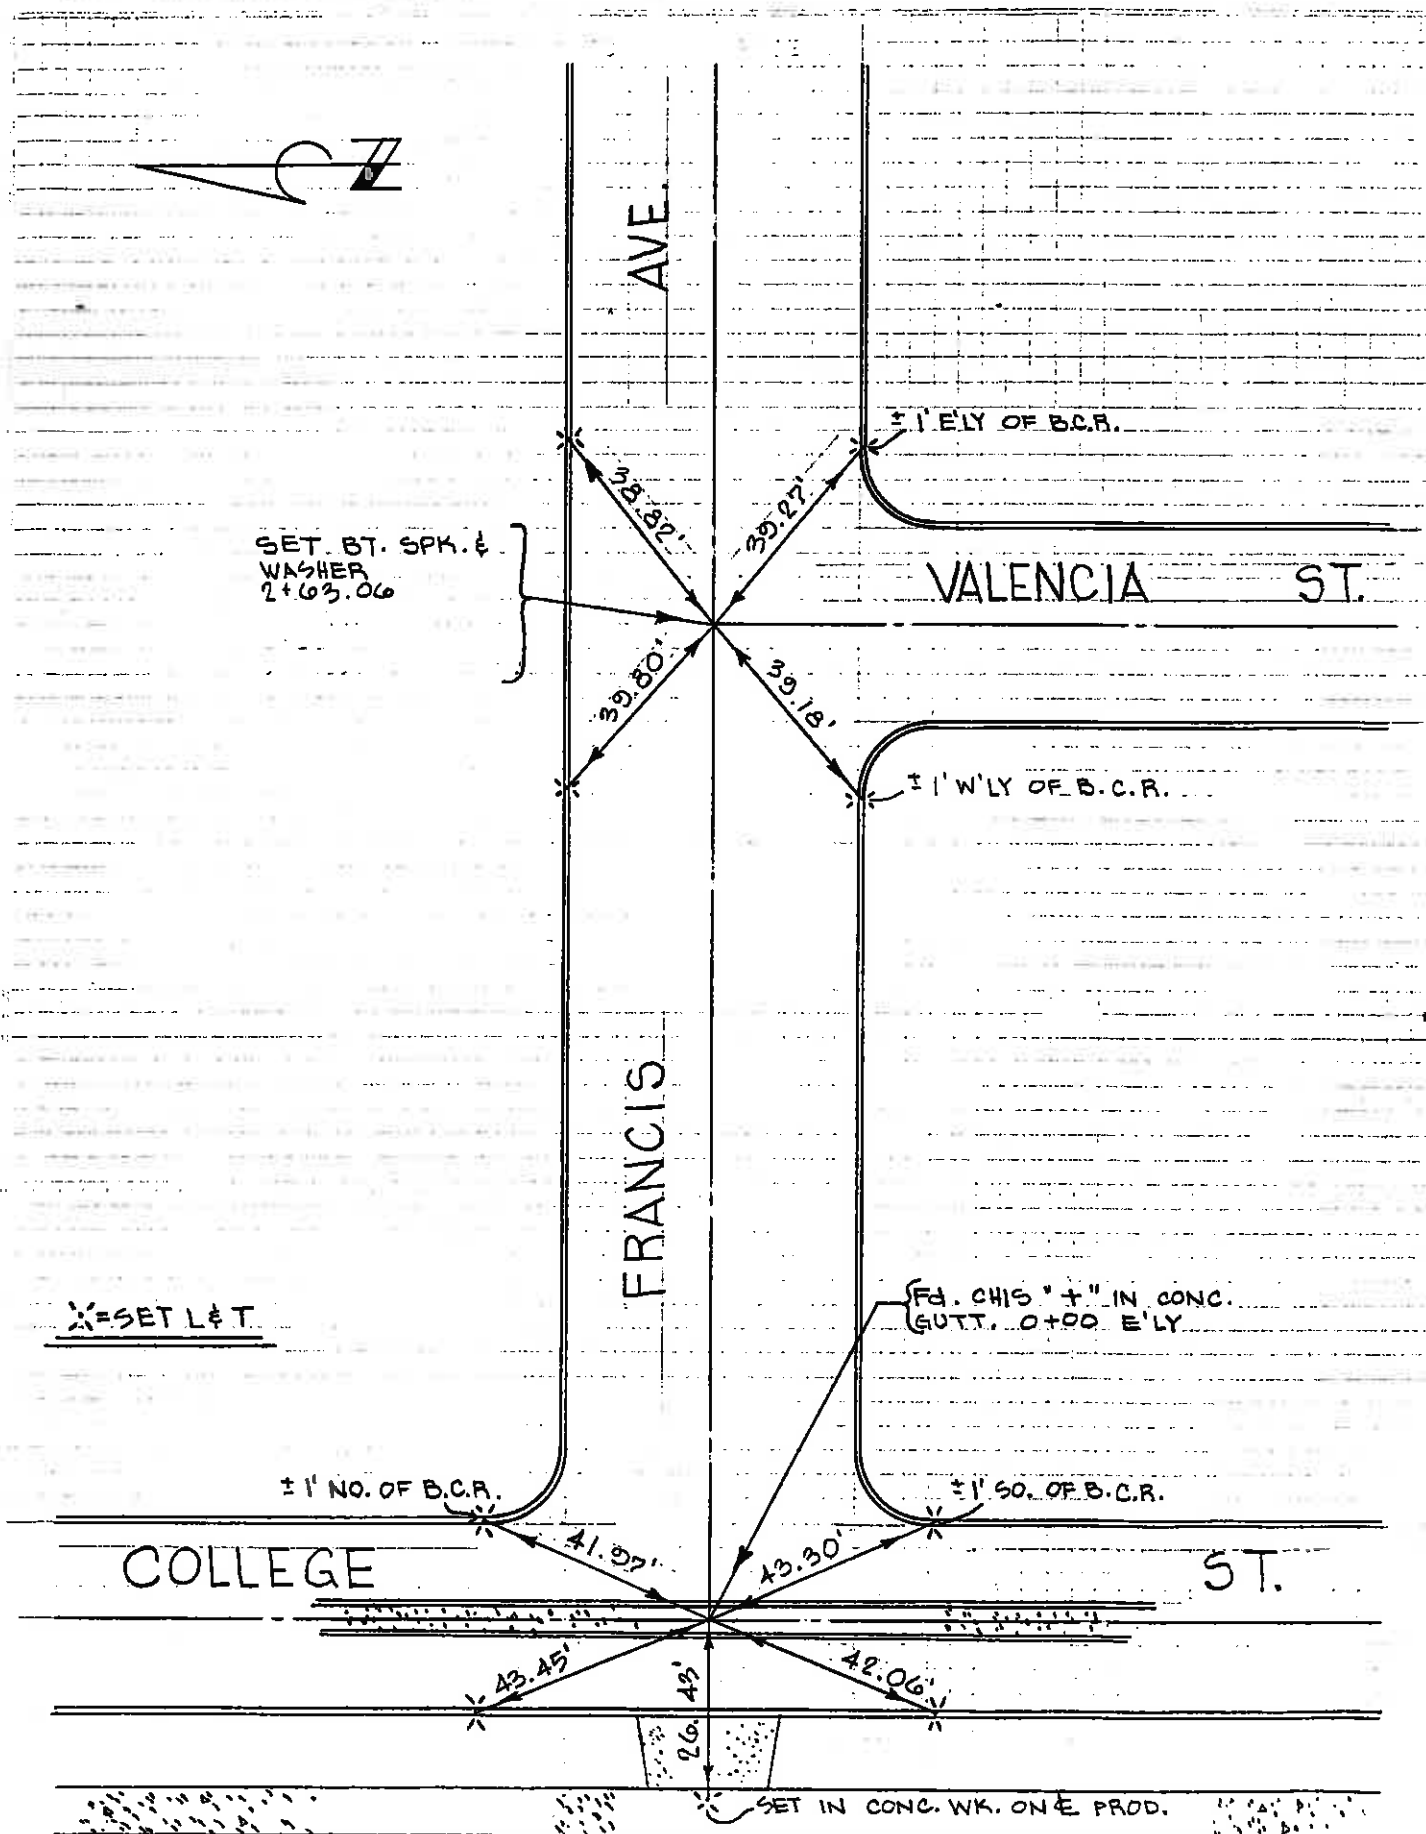


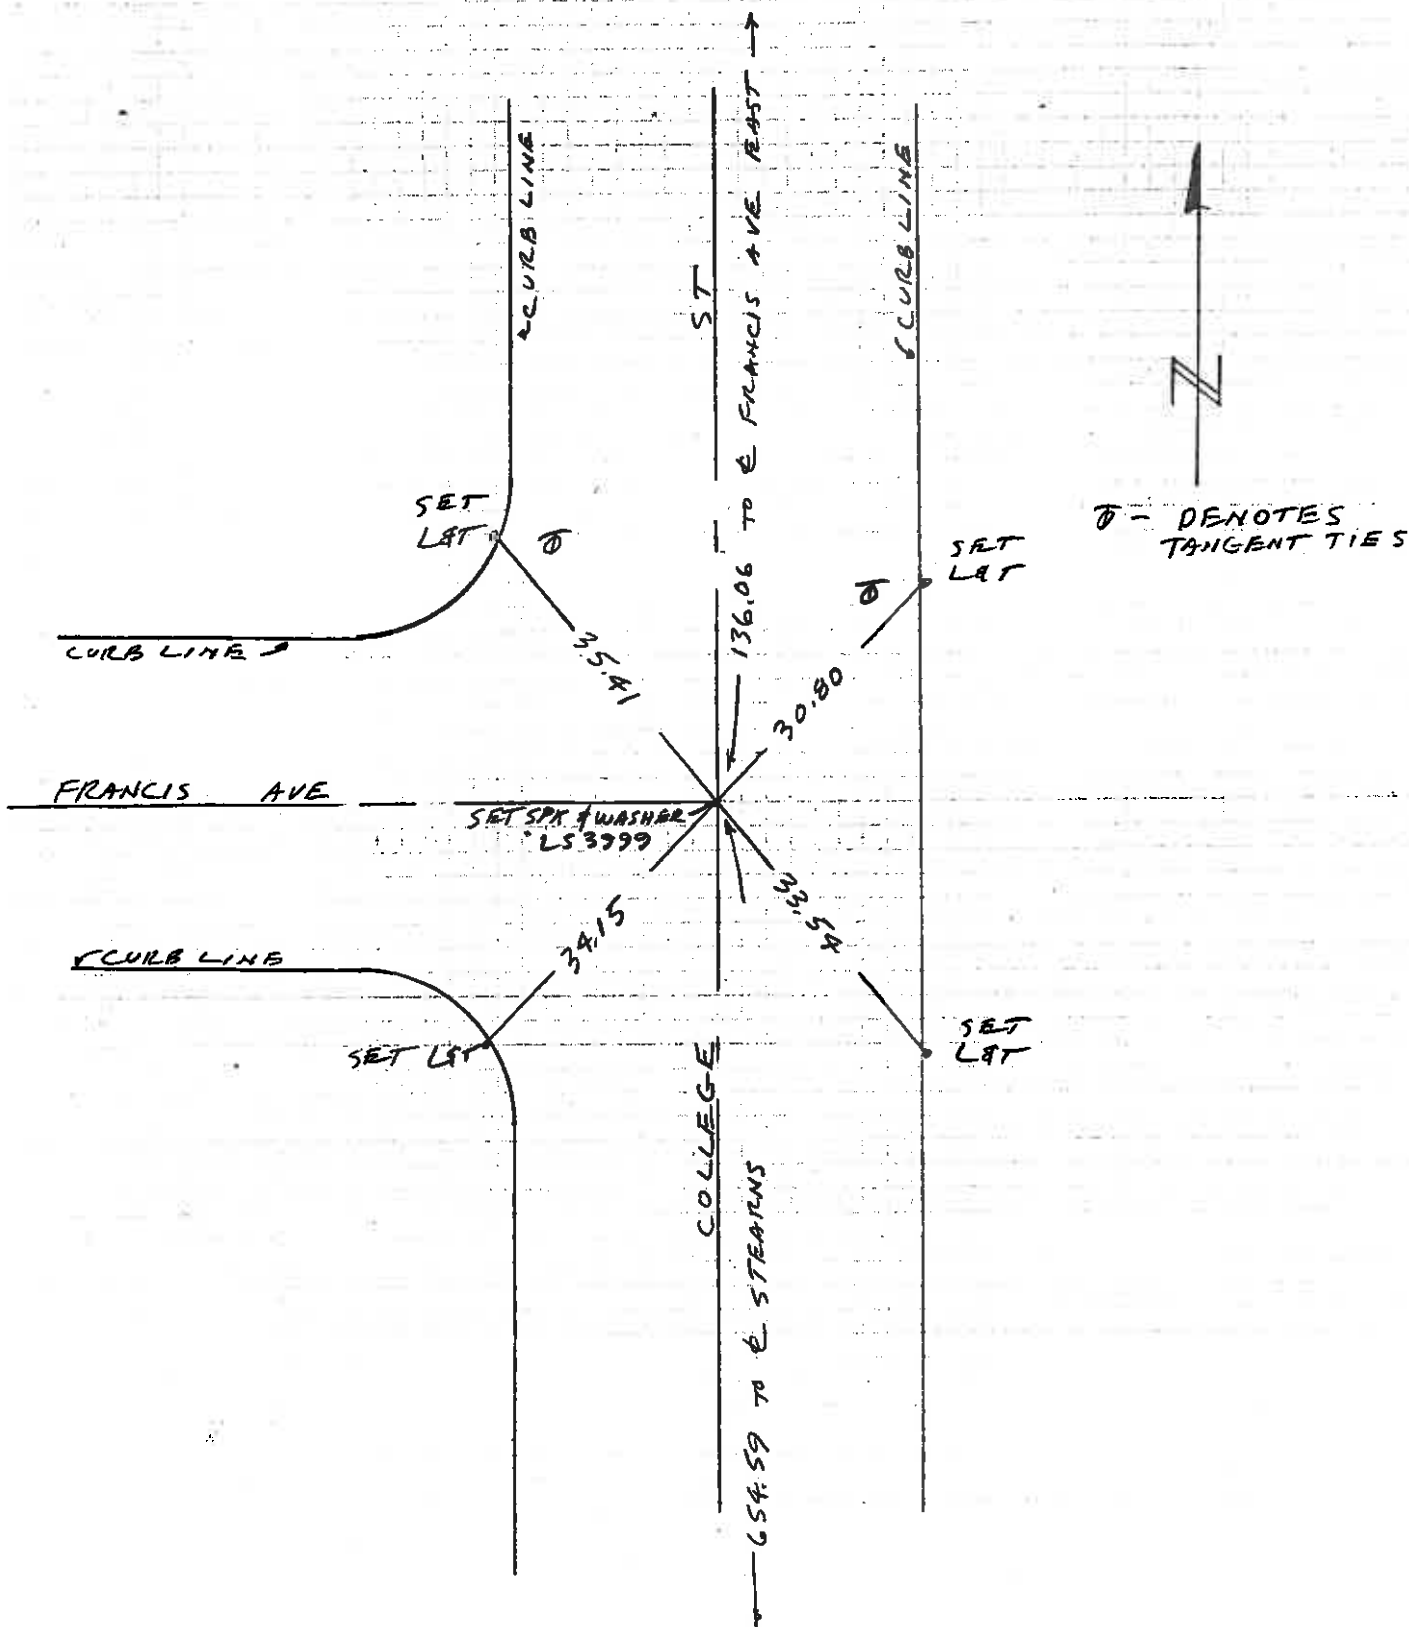


AND COLLEGE ST - CITY OF LA HABRA 5/14/85
SURVEYED BY


ORANGE COUNTY SURVEYOR

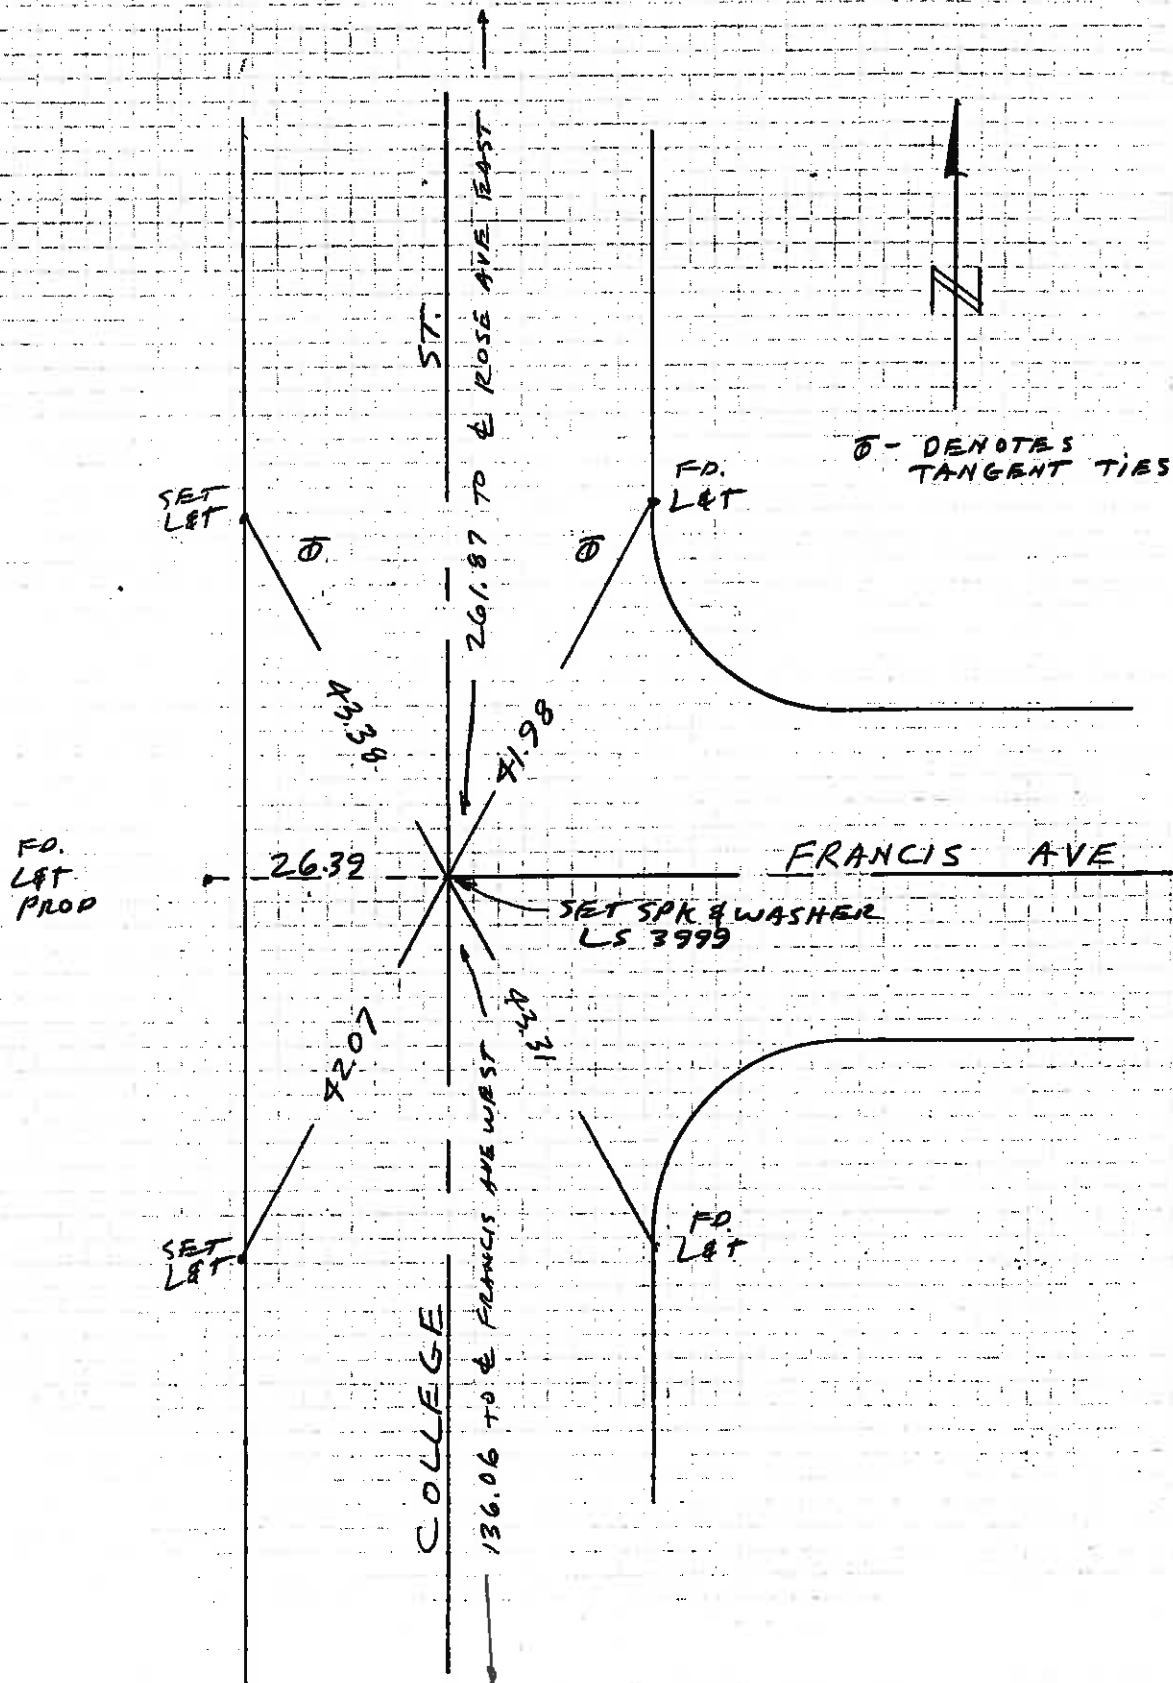


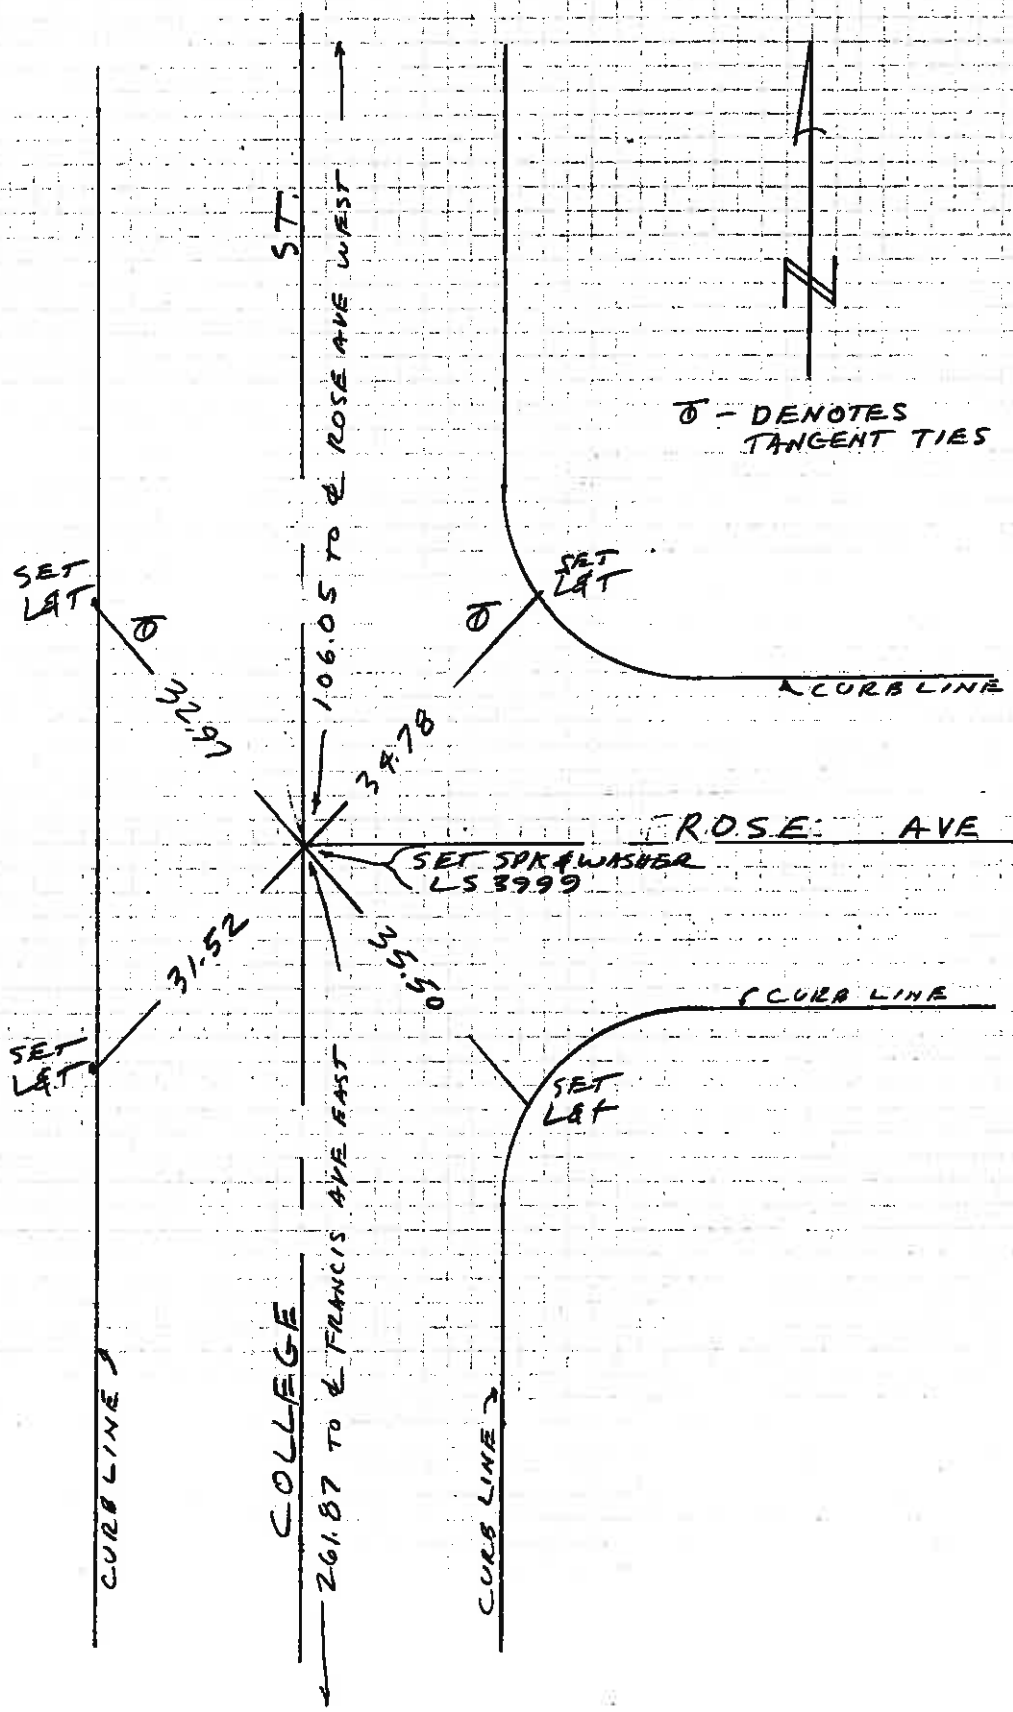

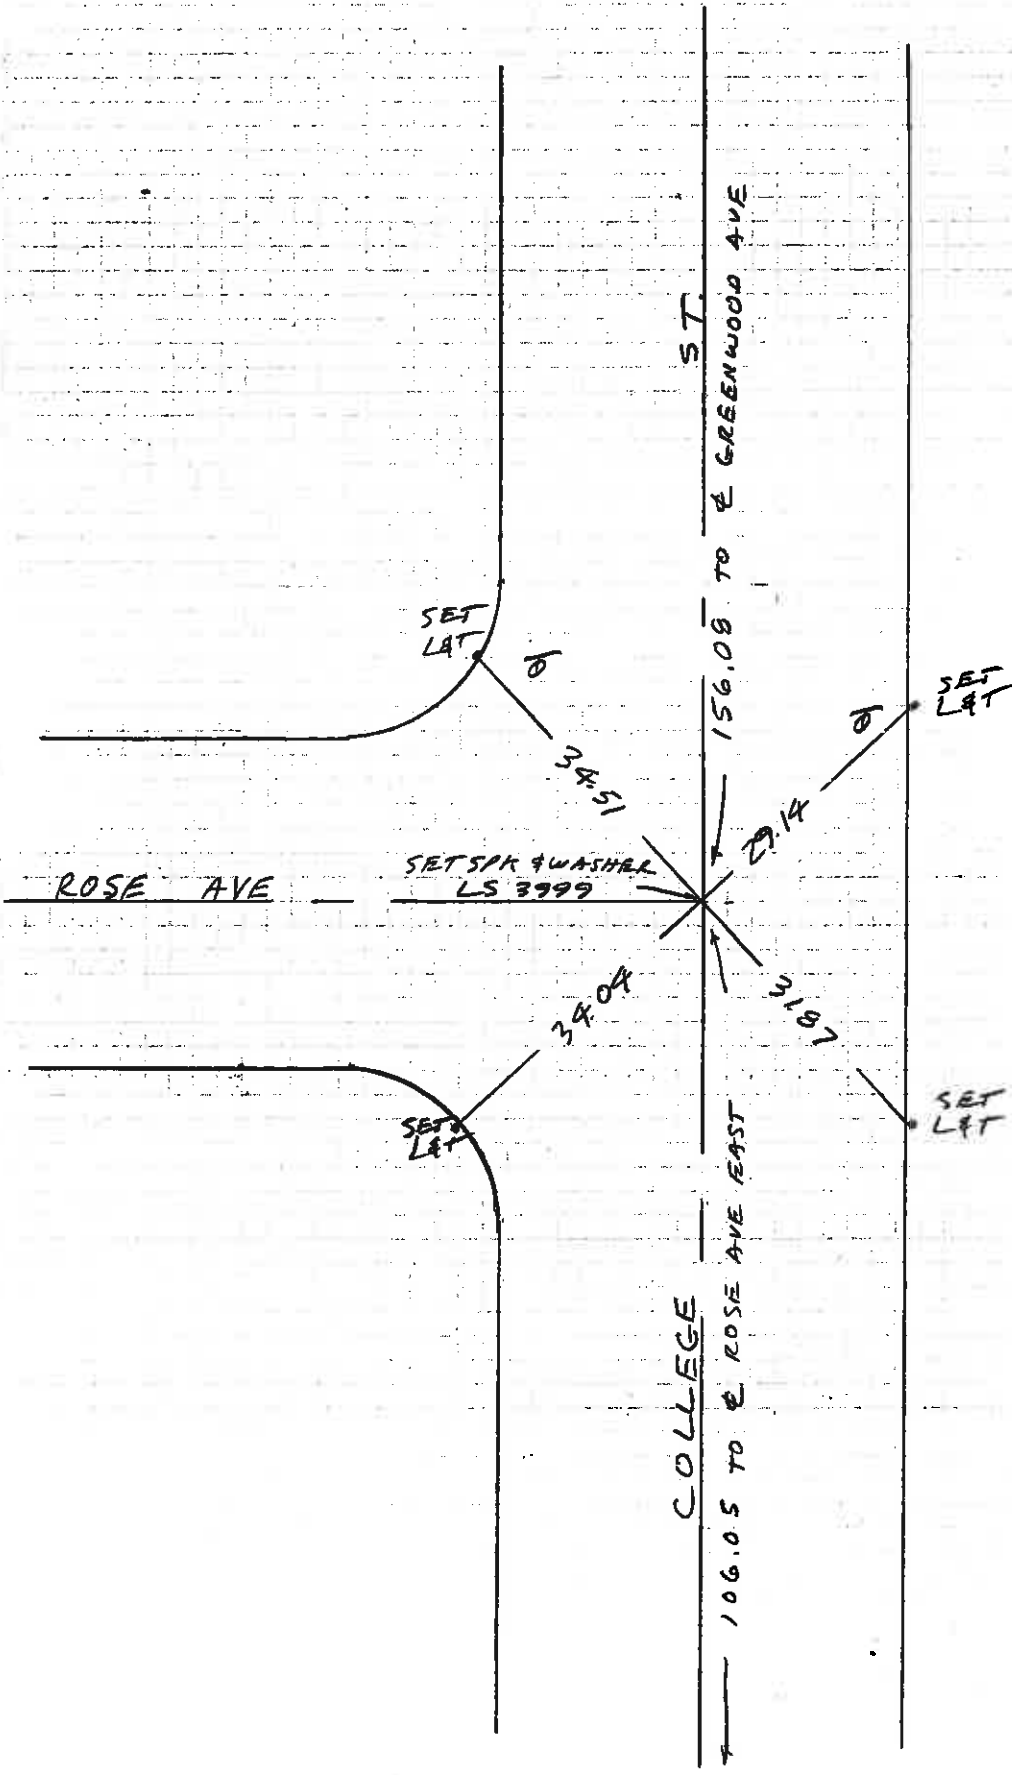



⊗ - DENOTES TANGENT TIES

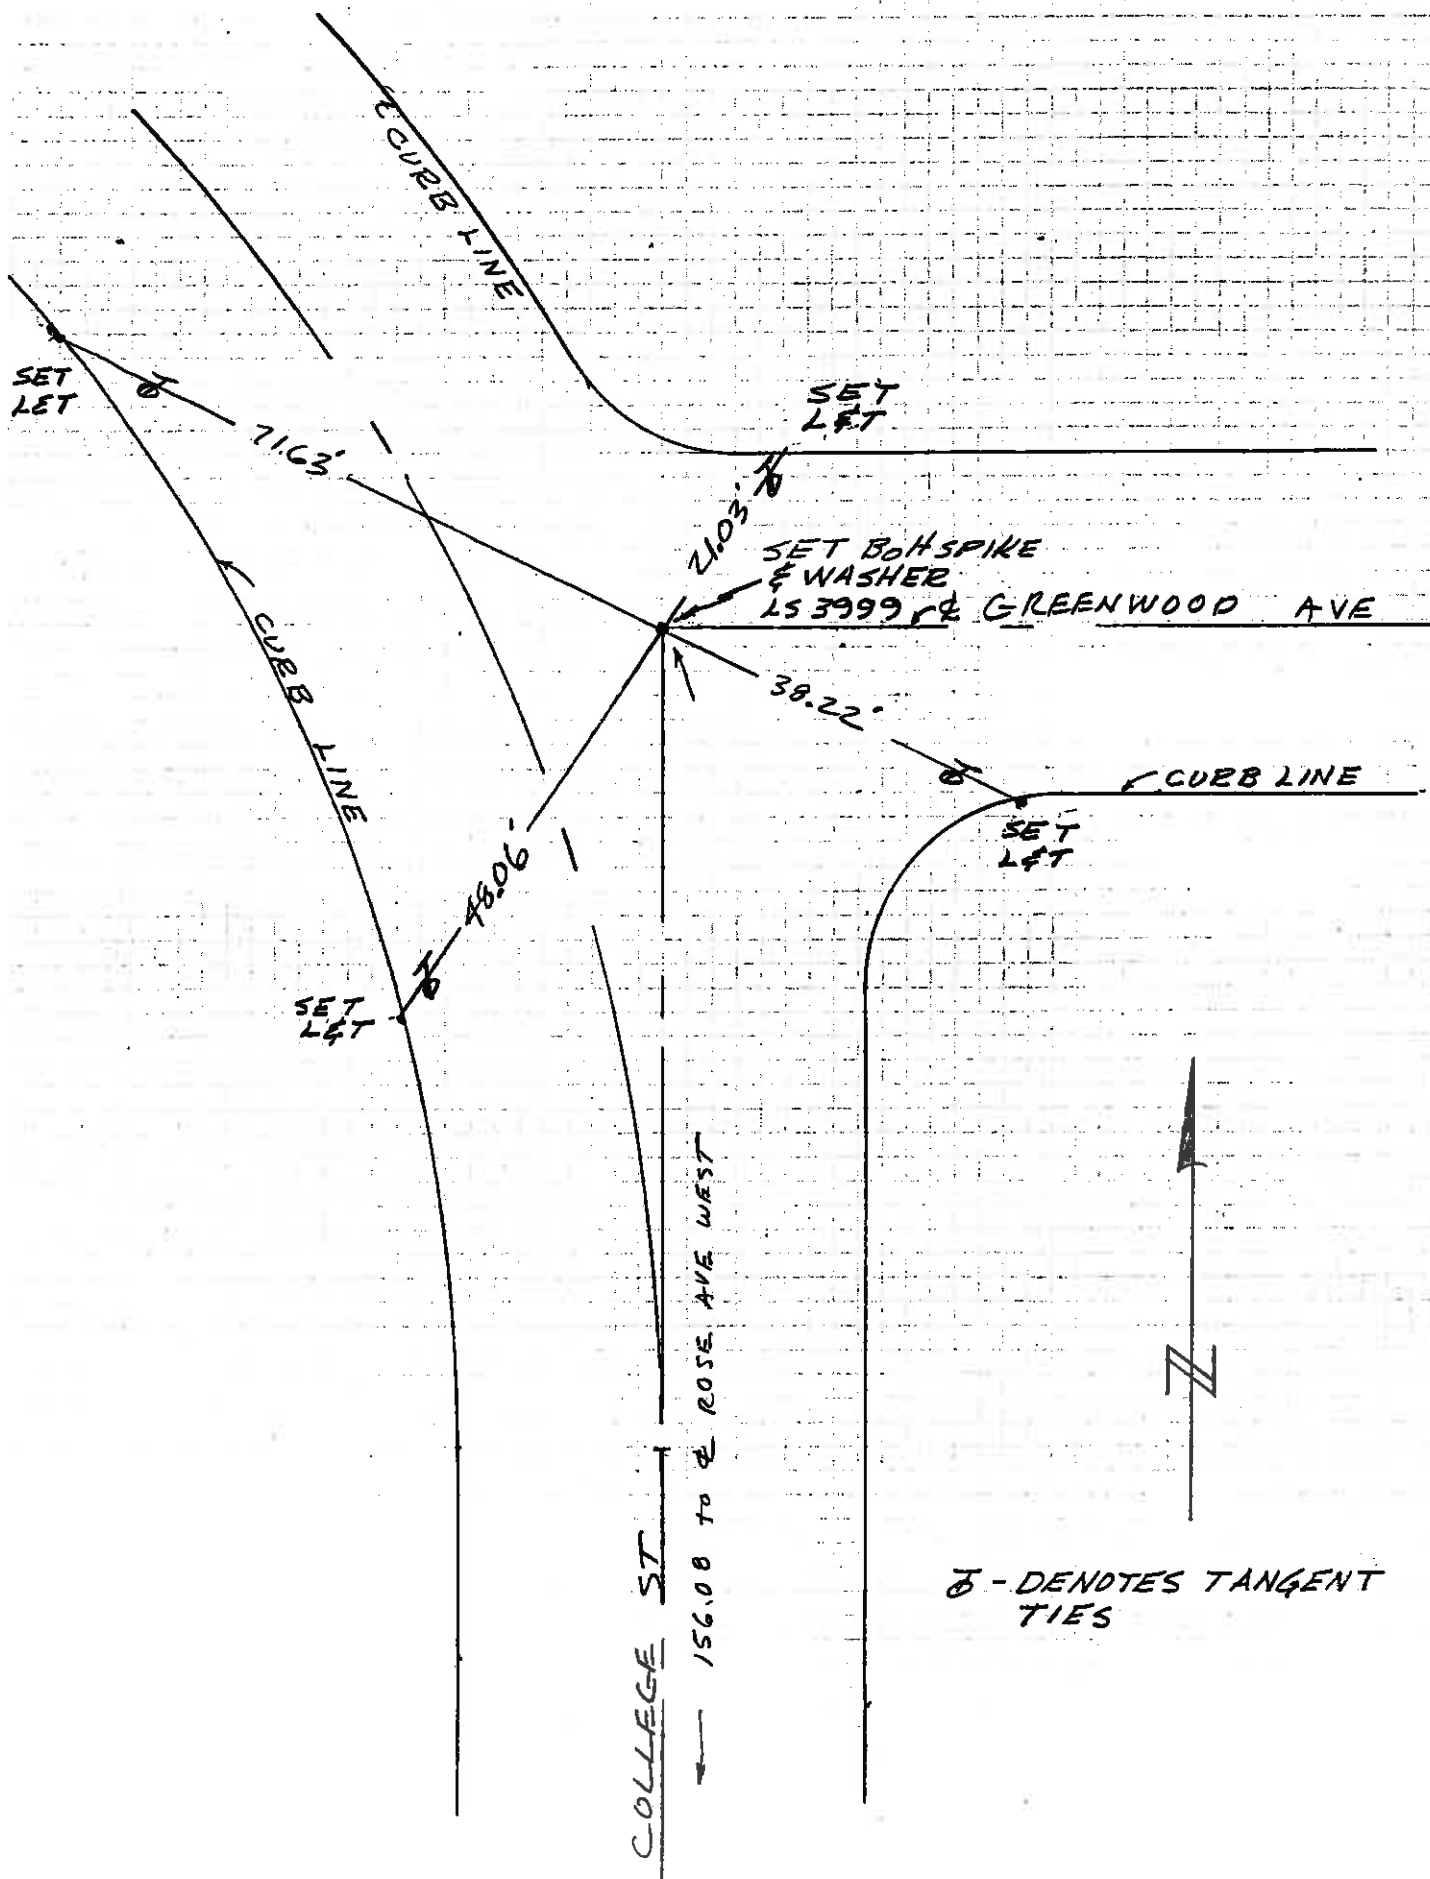

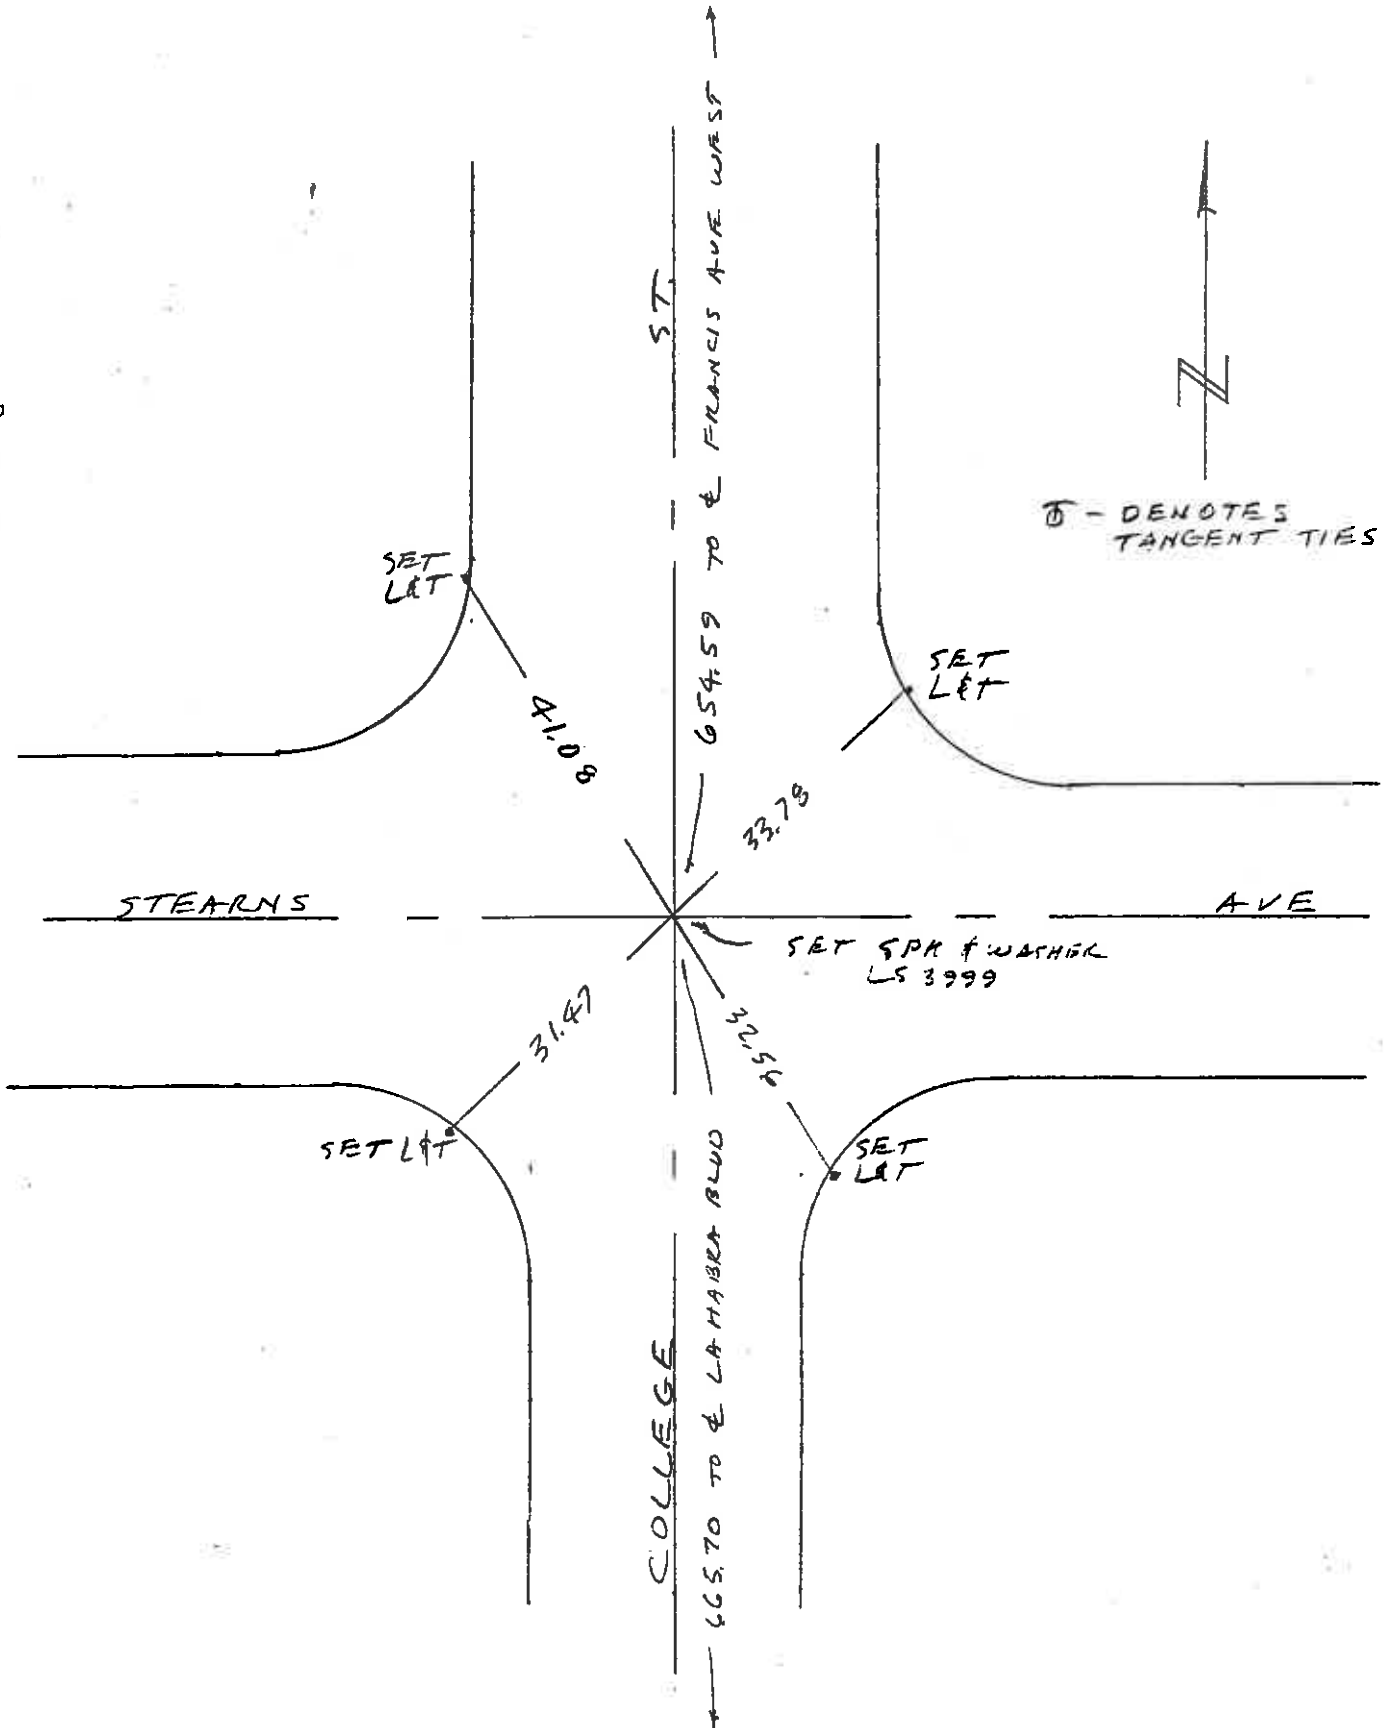

See bottom of Pg. 12

0 30 DP (TM 10.5)
221+63 ⁶⁰ Fd. Spk. & T.
Set Sq. Spk. T. & W.

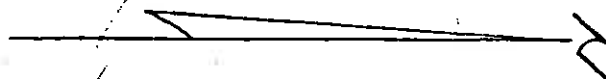

VII
B6447 M99
B6448 M90,91

E HACIENDA RD.
N 0° 24' 45" W

214+43 ⁵⁴ Whittier Blvd
10+00 Hacienda Rd.
(T.M. 10.3)
Fd. Spike & W. 0 ⁶⁰ DP
Set Sq. Spk. T. & W.

BLVD

E CORTO WAY
N 16° 24' 34" W

207+70 ⁴³ Nothing Fd.
10+00 Corto Wy. Nothing Set

WHITTIER
N 84° 18' 30" W

198+57 ³² P.O.T. = Nothing Fd.
198+57 ⁸⁹ E.C. Nothing Set

197+58 ⁰⁵ (BK) =
197+57 ⁸⁹ (Ahd)
(T.M. 10.3) Fd. Spk. 0 ⁴⁰ DP.
Set Sq. Spk. T. & W.

CURVE DATA

$\Delta = 5^{\circ} 43' 30''$
 $R = 2000'$
 $T = 100'$
 $L = 199.84'$

E IDAHO ST.
S 0° 04' 00" E

10+00 Idaho St.

Set Sq. Spk. T. & W.


11+00

12+00


17


APRIL 1960


KESWICK & DTY

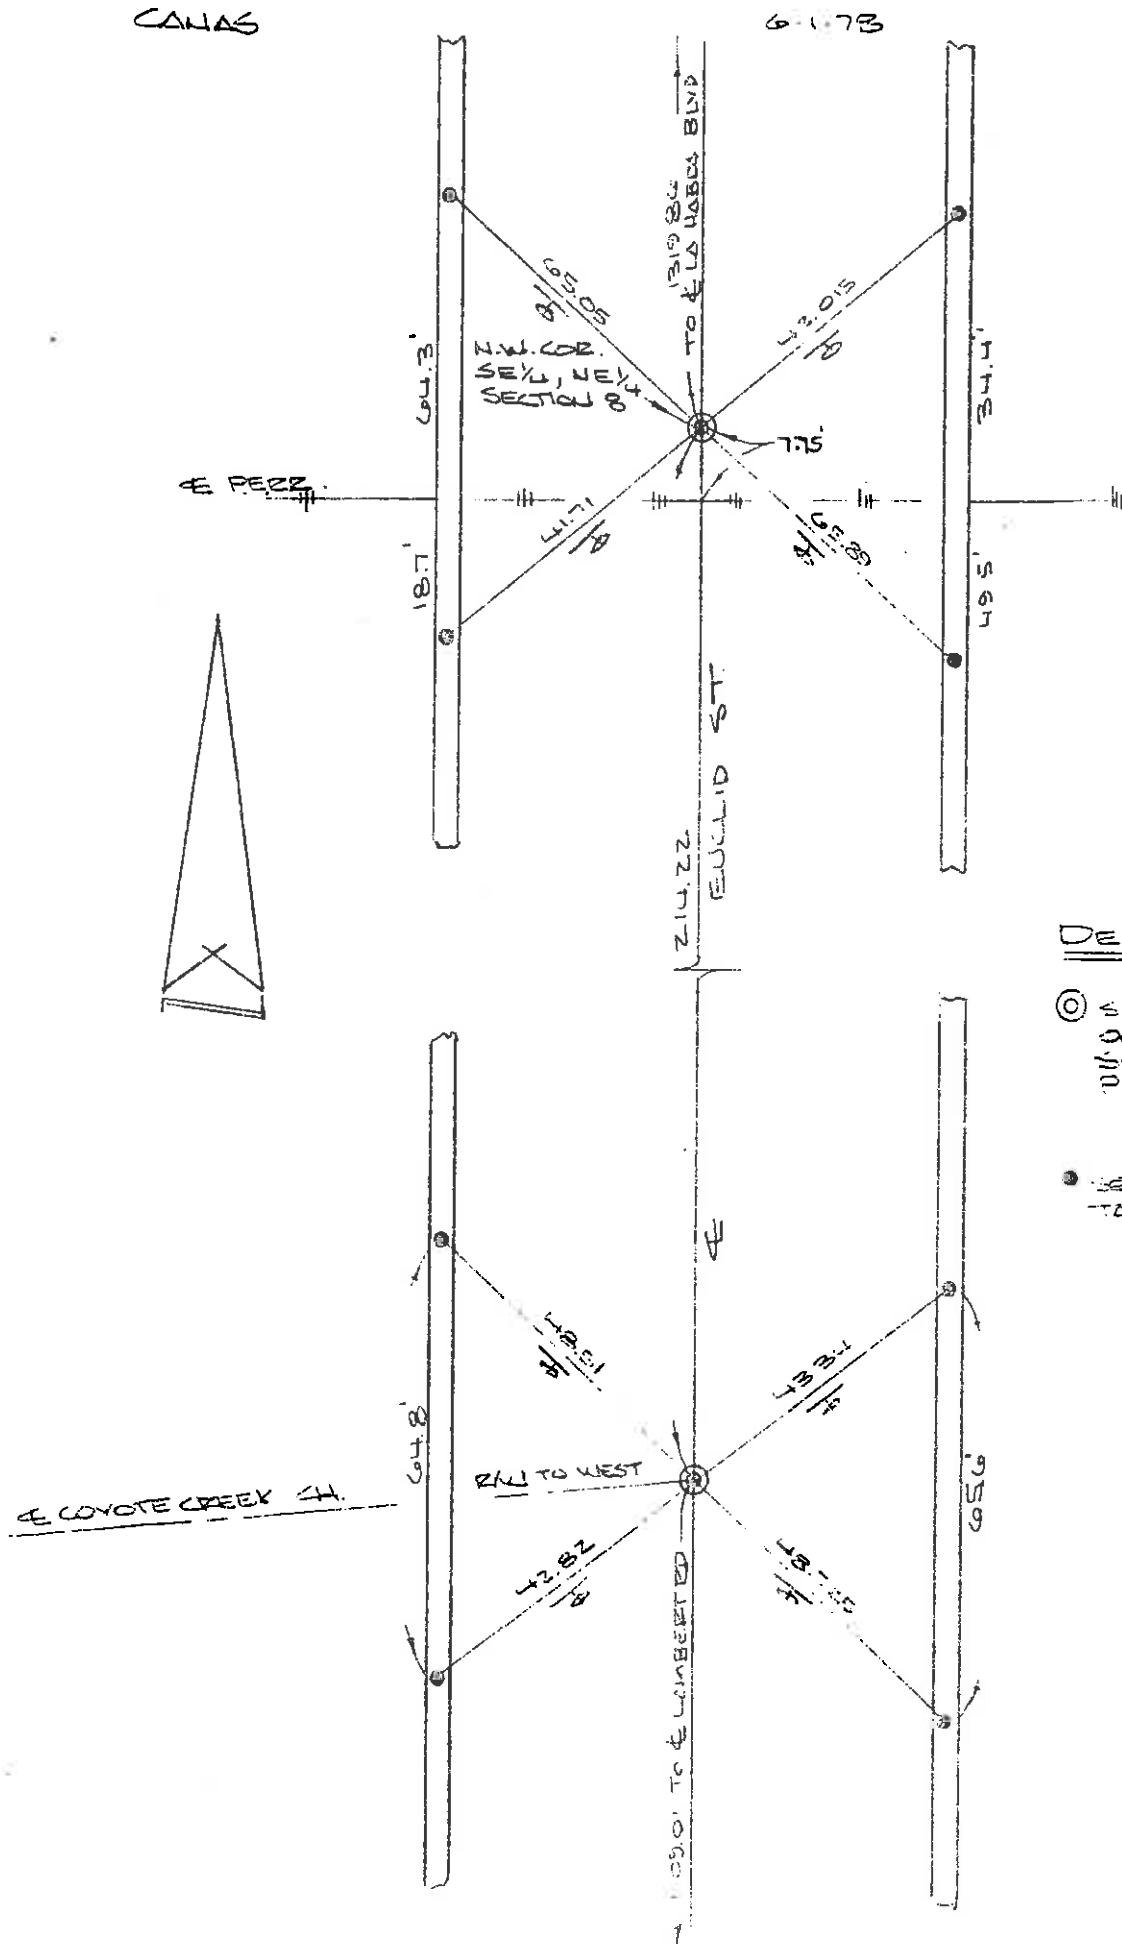Denotes

- ② SET ON SPK. E
OCS TIE ON PAVED
SURF W/ 4-2" Ø
PUN SPK. TIES

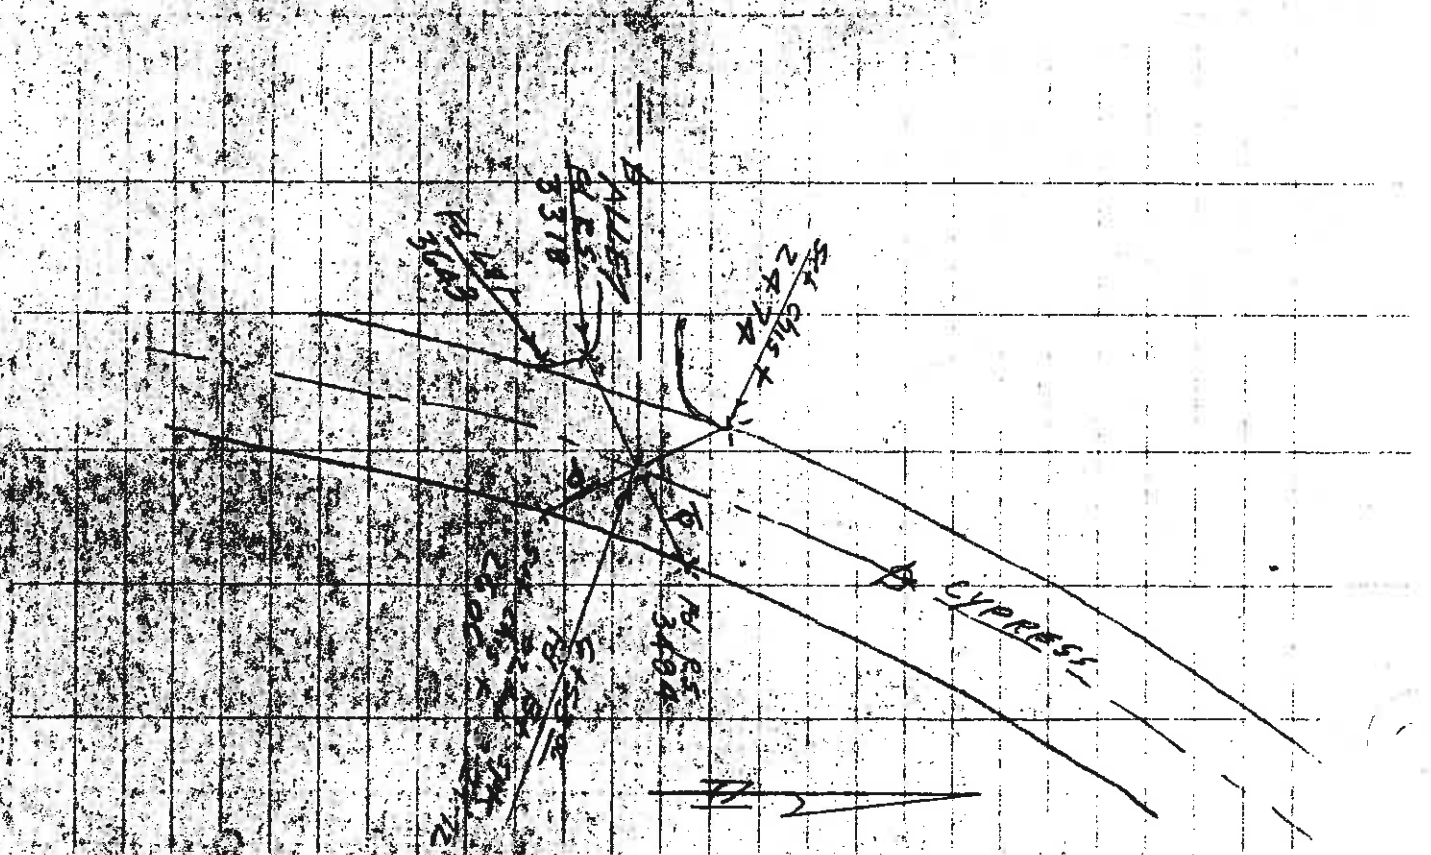

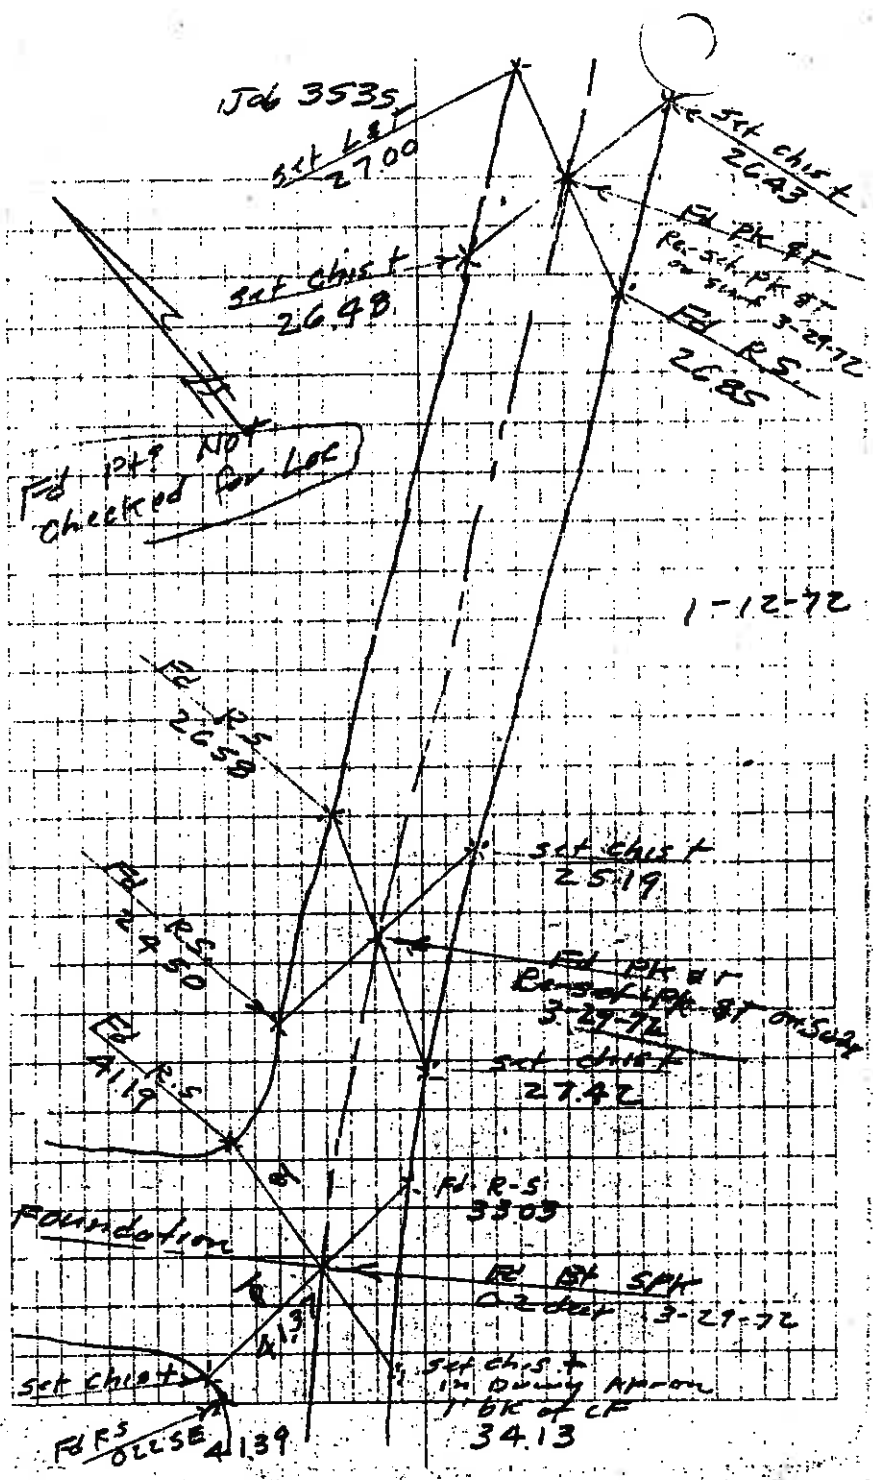


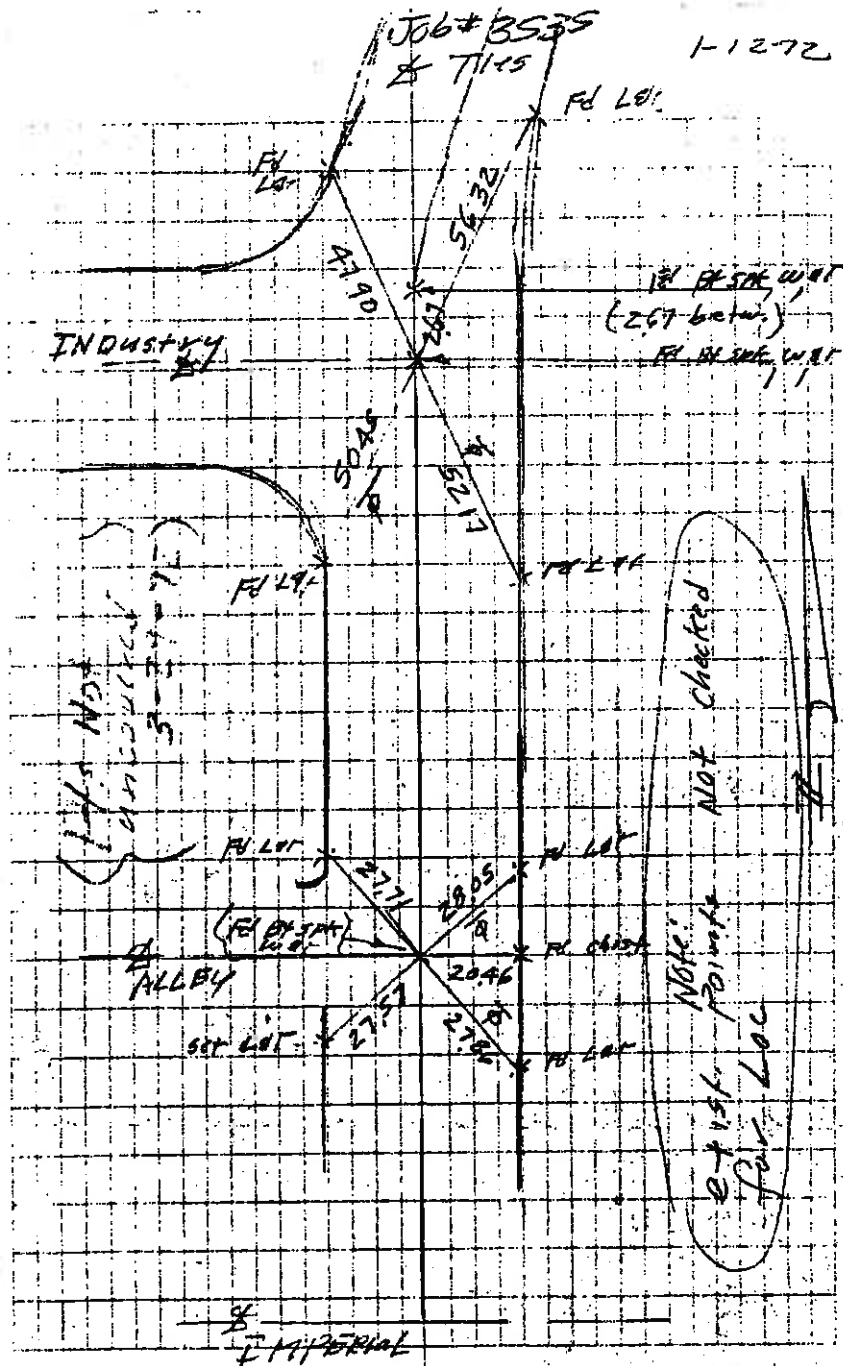

U6 3835
FINANCIAL TIES

17 uella.

75-26 29873
Clem 776

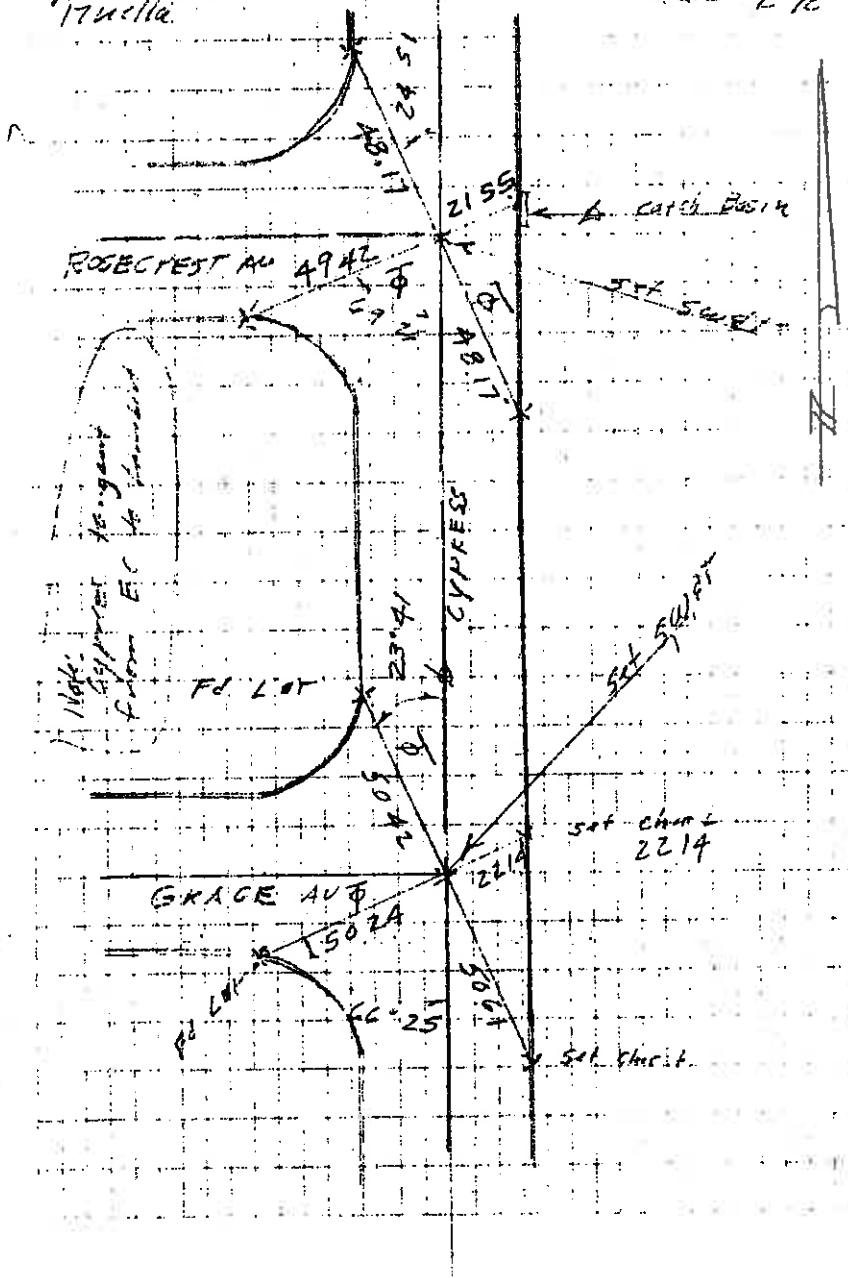

He / version

174612

March 29, 1972


clear $T = 68$

Tab # 3535

FINAL & TIE

Note:

The Cypress
Tangent from
EC to Lambert

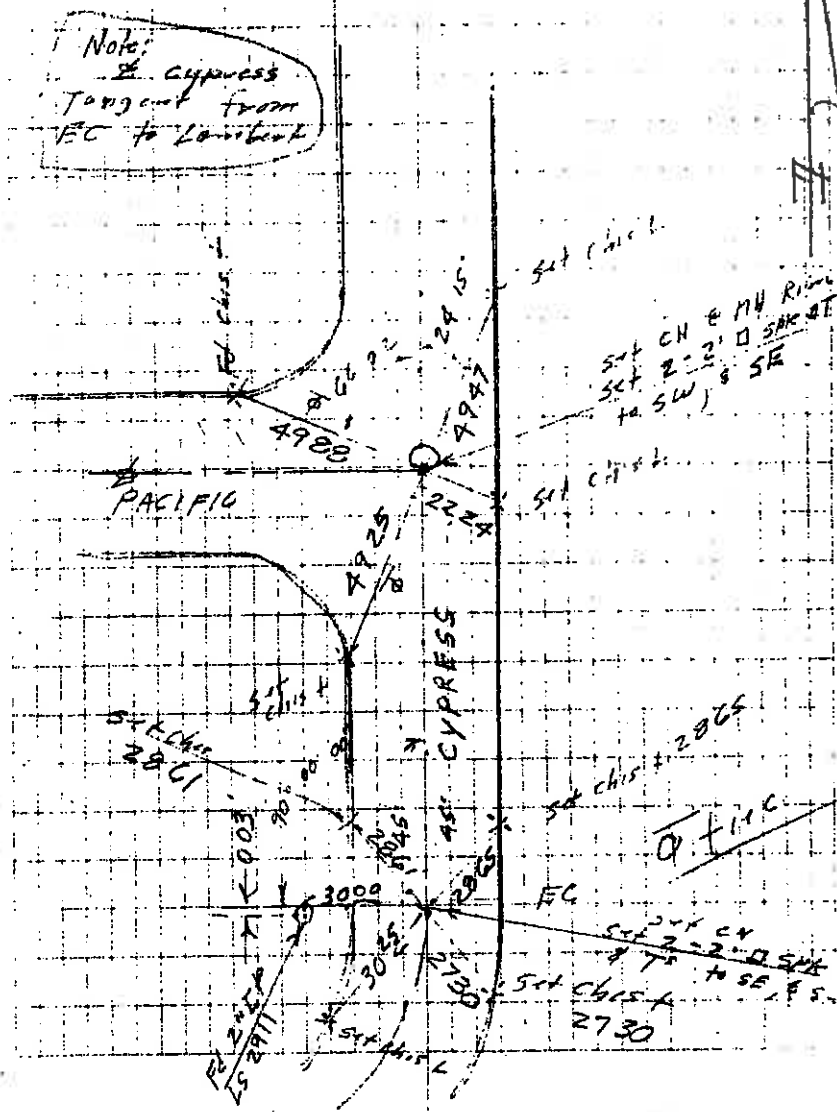


Job # 3535

Construction ties

Holmes
Metcalf

1-12-72

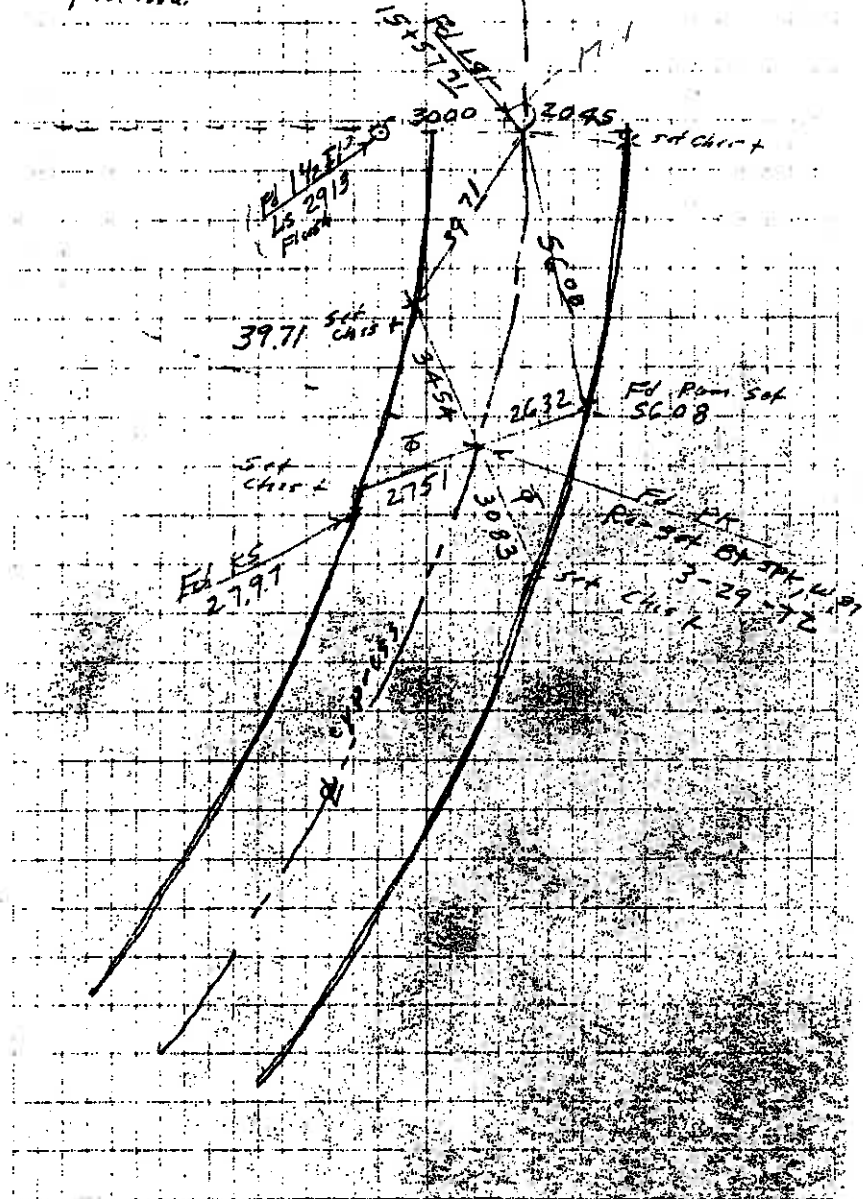

Job # 3535
Final & Ties

LAMBERT RD

0.57m in H.W.

108.49

64.25

52.40

1.5

1.5

Note:
Cypress from front
EC to Lambert Rd

PENITAP AD

CYPRESS

41.37

49.31

46.07

47.84

46.07

47.84

46.07


TIES- LA HABRA BLVD & CYPRESS

HILDEBRANDT


12-77



CYPRESS

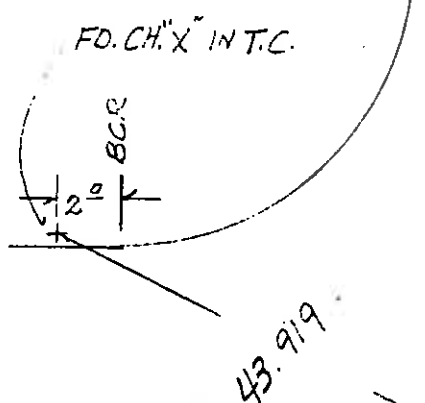

43.919

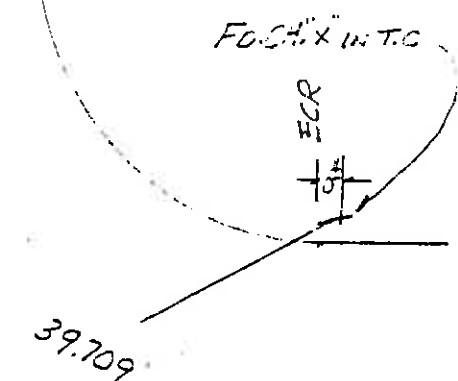


39.709


LA HABRA
BLVD.

43.518

33.967

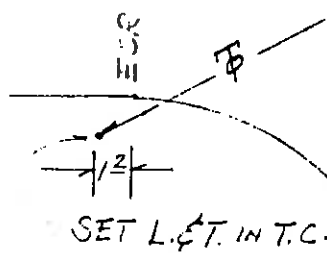



FD. PUN. SPK & D.S.S. TAG
SET 4-2" CUT SPIKES
& 2-1/2" TIES
REPLACED W/O.C.S. MON. WELL
& BRASS CAP STAMPED "12-77"
ALSO SEE R.S. 99/15 & 16

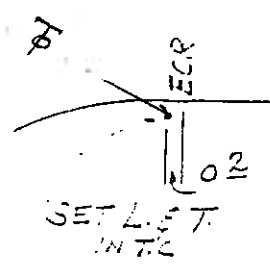

3

LA HABRA

Using the Bolt of Walnut St. as a backsight
and the S.W. & T. of Fullerton Rd. as a
foresight, the Angle of Cypress is 0° 01' to the left.

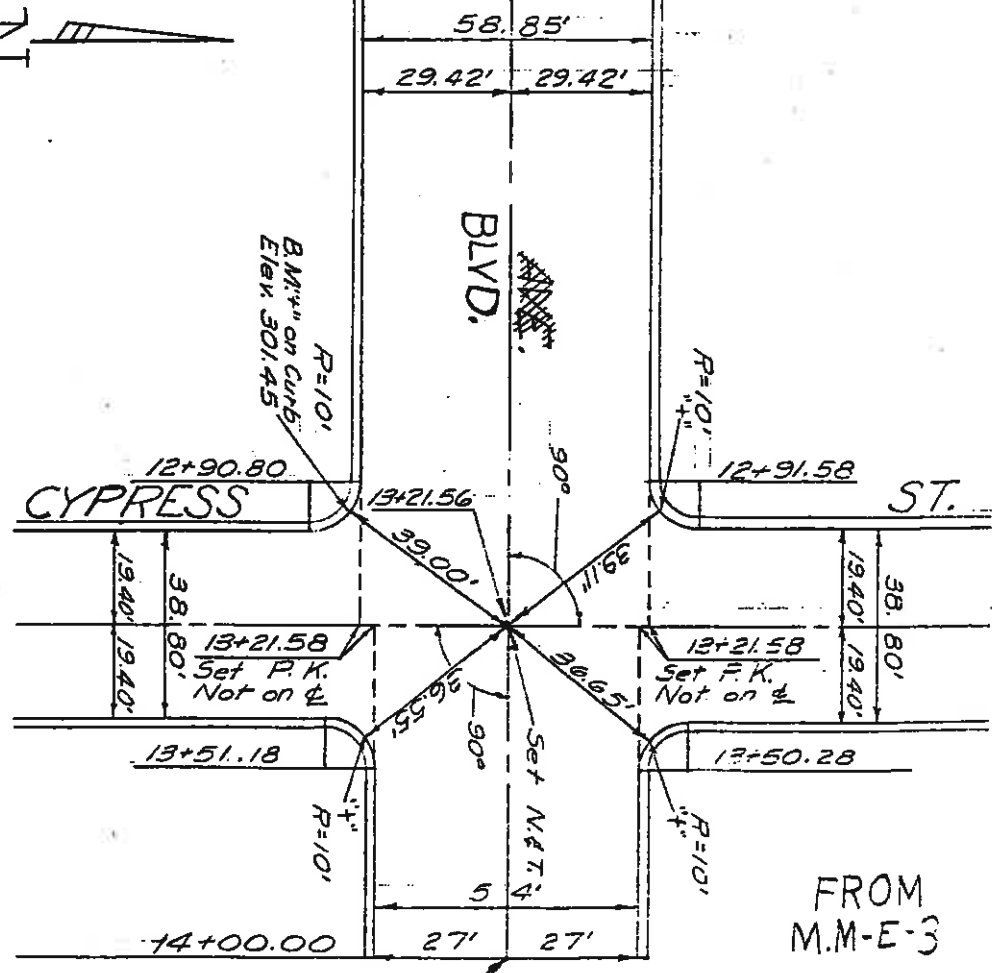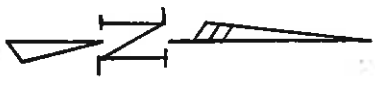

FROM
M.M-E-3

~~26+20.82~~
~~COLLEGE~~

27.75'
15.12' 13.12'

~~26+62.80~~

TICE

TICE ENGINEERING SERVICES

17611 Yorba Linda Blvd.
Yorba Linda, California 92686


JOB NO. 861005 SHT. 1 OF 4

PROJECT 2ND AVE. LA HABRA

DATE 3/10/87 BY D.W.

CITY OF LA HABRA
CENTERLINE

SECOND AVENUE
TIES

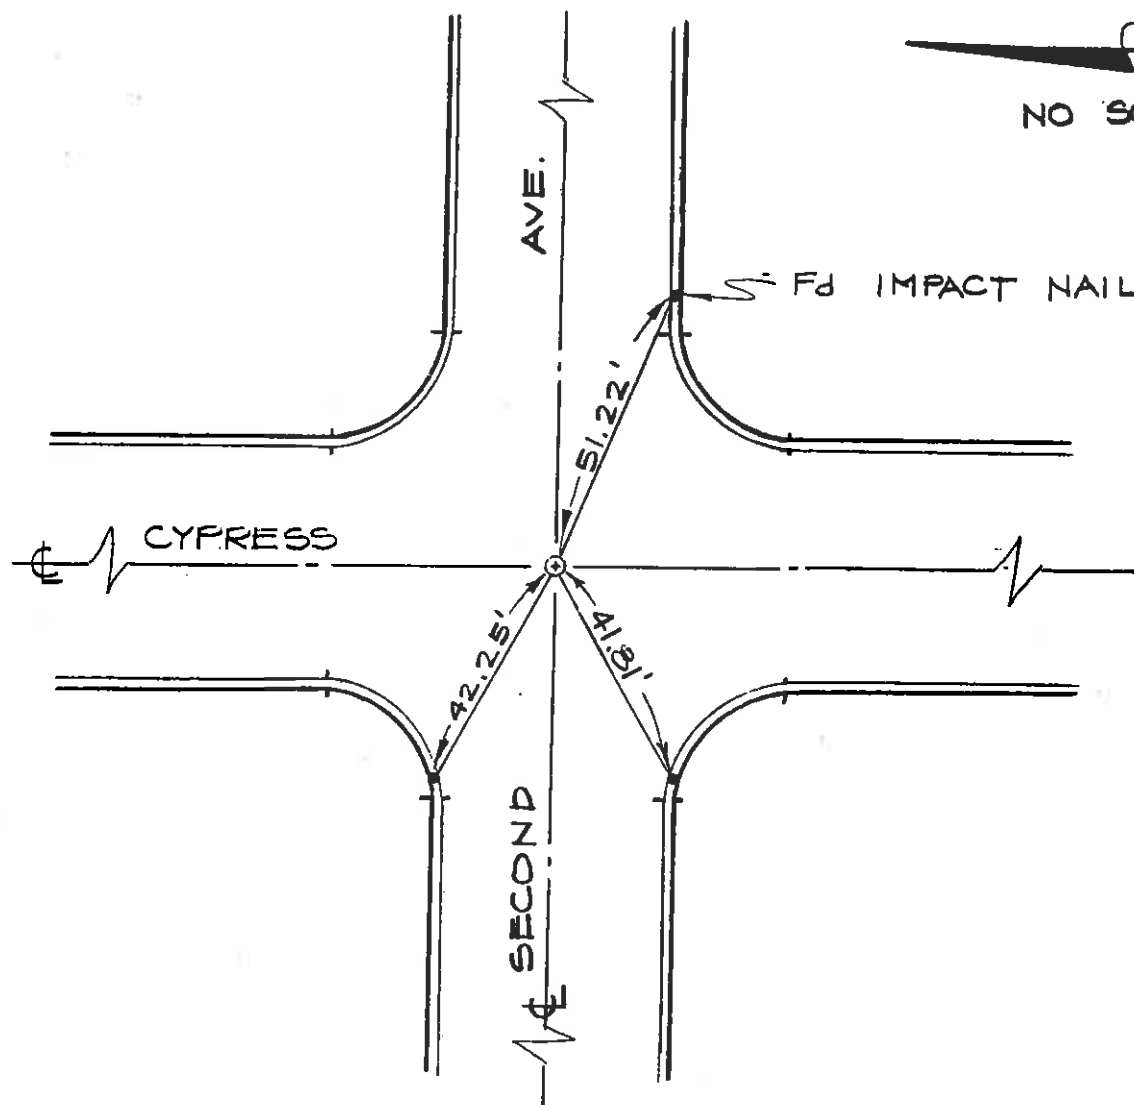


NO SCALE

- SET 6" SPIKE WITH WASHER "L.S. 5196"
- SET LEAD AND BRASS NAIL IN TOP OF CURB UNLESS NOTED.

CAVUS

6-1-78

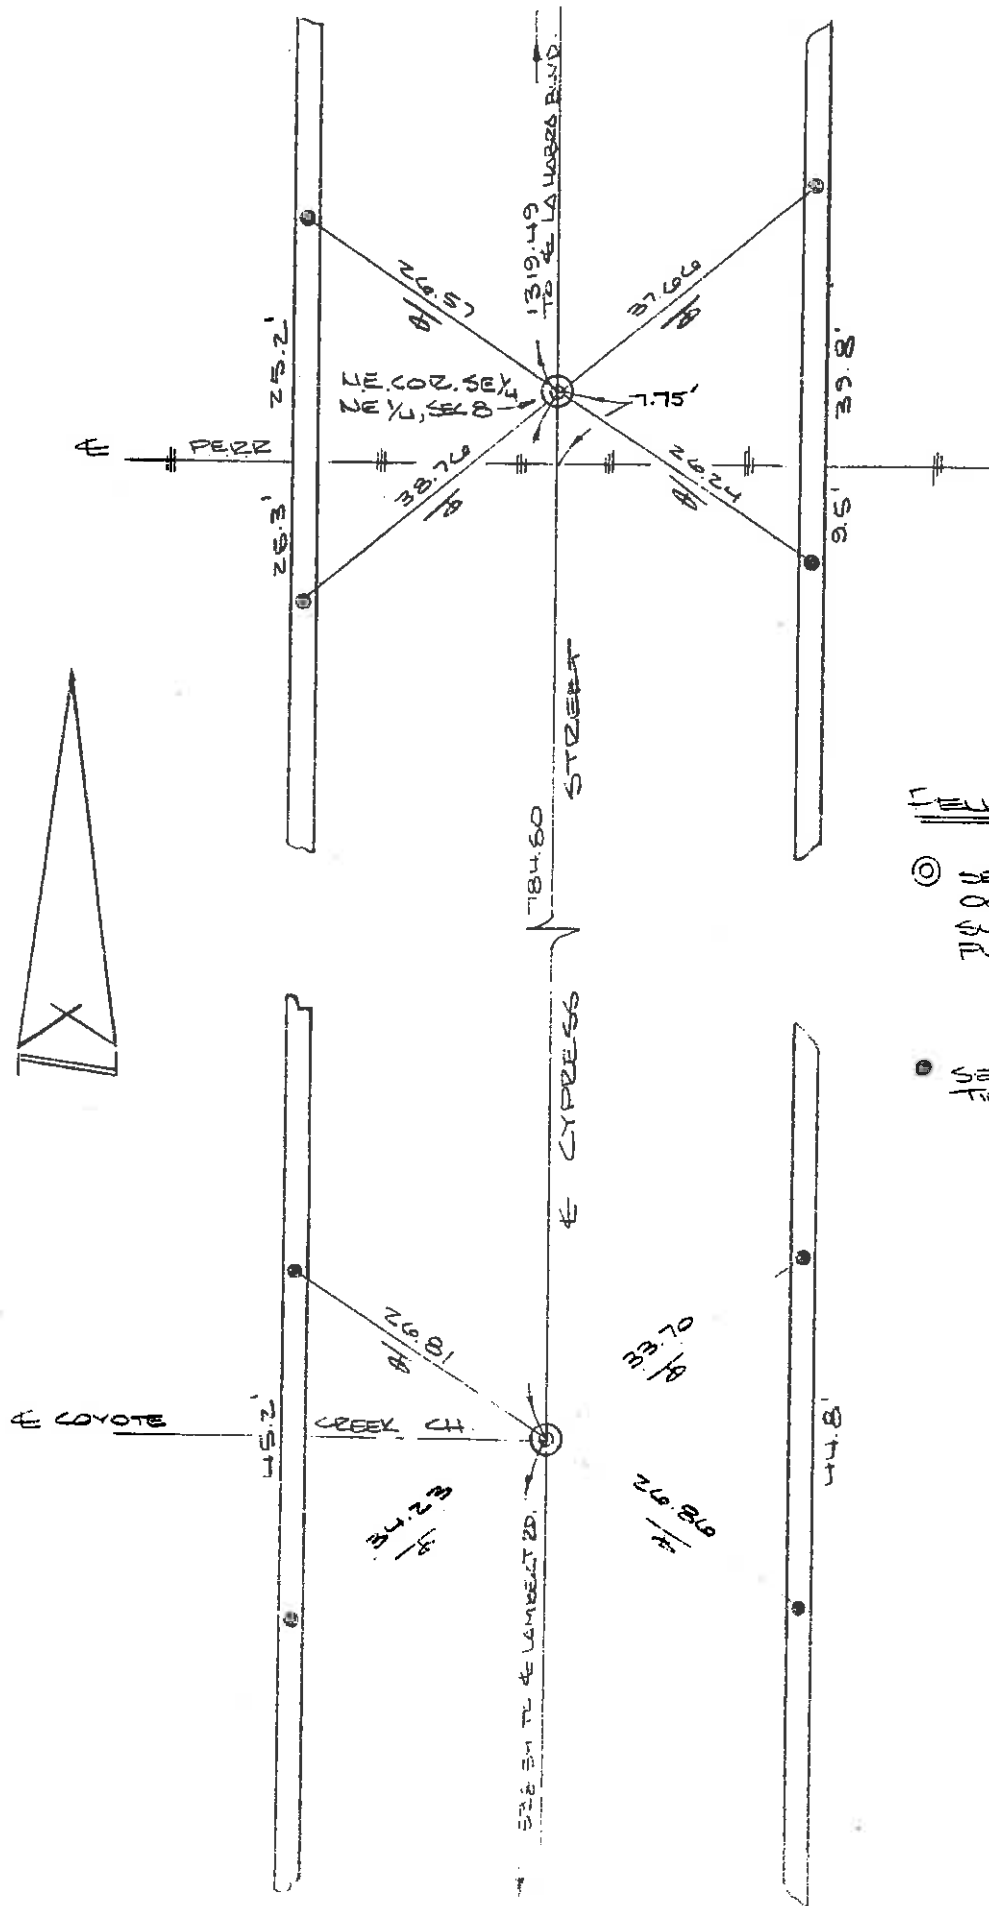

NOTES


① SET FUN. SPK. & OCS TAG ON PAVED SURF W/4-2" FUN. SPK. TIES

● SET LEAD & OCS TIE TAG ON T.C.

6-22-70 WHRM 19 24
ADAMS & Dty. whitey

TIES
WHITTIER BLVD &
CYPRESS ST

ORH 72 9.2/11.9
07212-26J234
SUR. #70-217

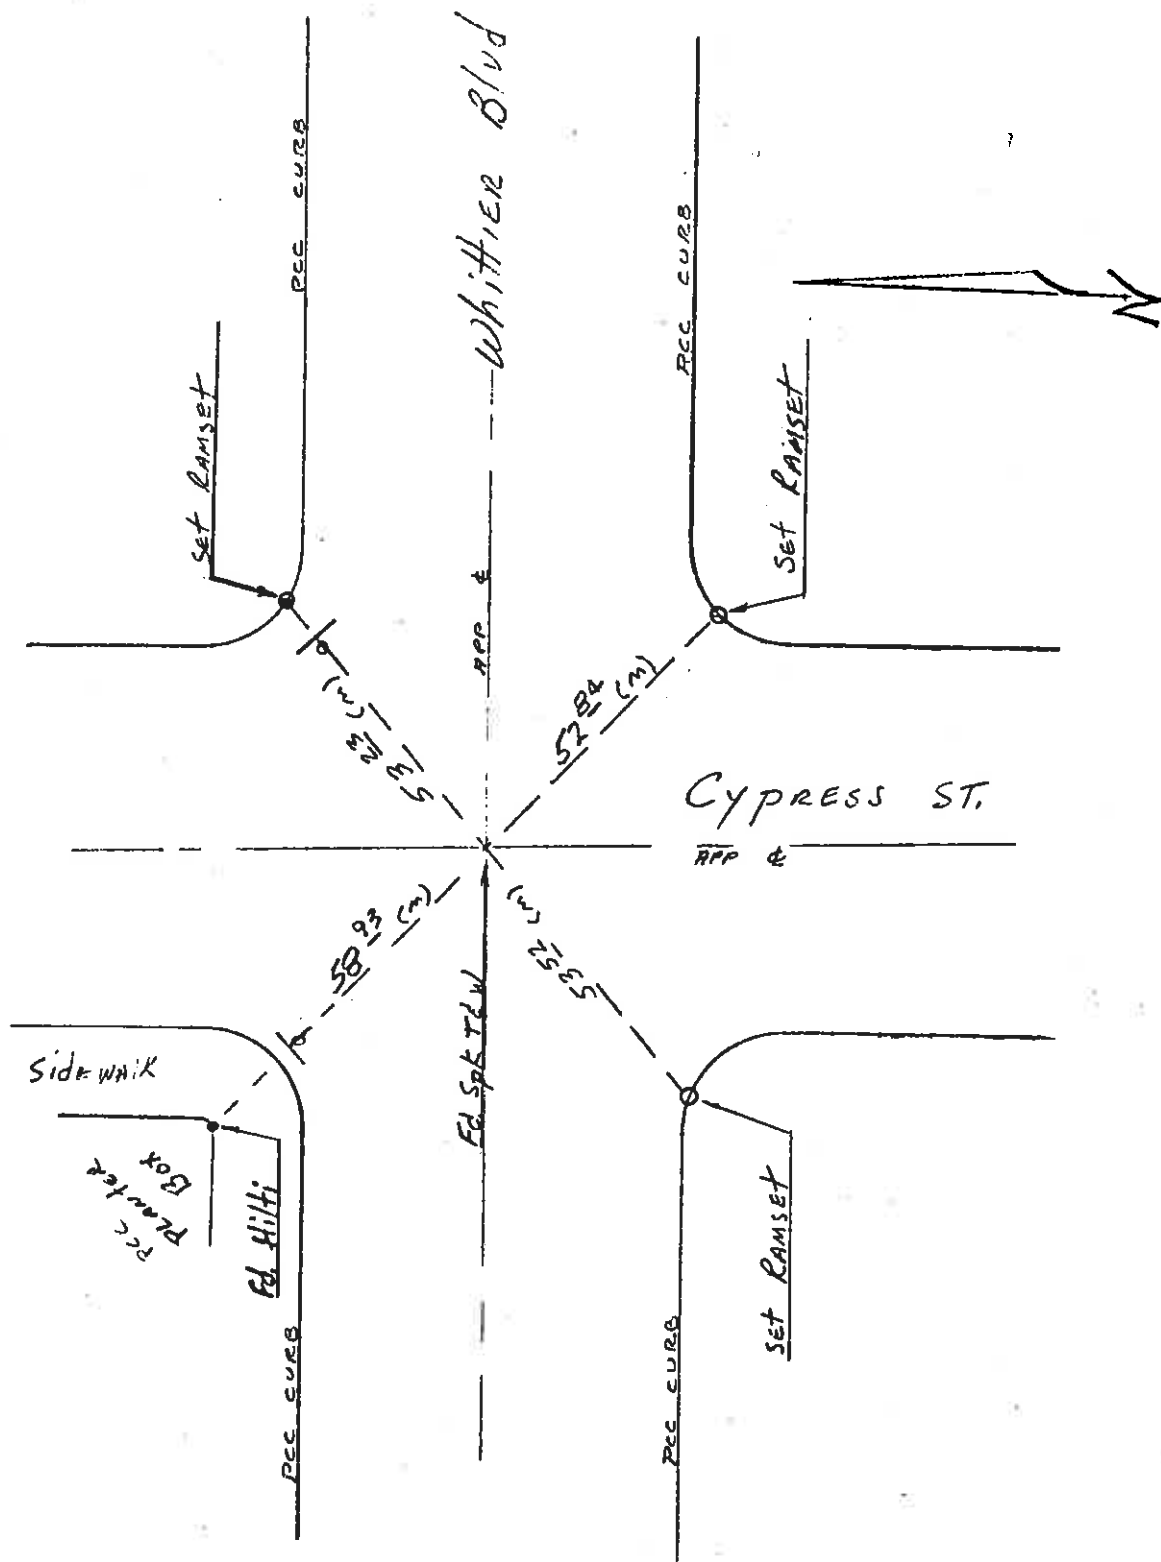

ORA 72 7.5/11.4
35743M

WHITTIER BLVD TIES PRIOR TO
RESURFACING

4-21-78
WINTER

13 36
PW

BLK 6448 MOD 97

REF. A10.001-6,75
A000720-21

78-066

C013

