


CHECK AND VERIFY ALL DIMENSIONS BEFORE PROCEEDING WITH THE WORK. REPORT DISCREPANCIES TO THE ENGINEER. ALL CONSTRUCTION SHALL CONFORM TO THE C.B.C.


ENGINEER:

PROJECT:
AMERICAN CROWN CIRCUS
LA HABRA MARKET PLACE
1641 W. IMPERIAL HWY.
LA HABRA, CA


MARK	DATE	REVISIONS
1		
2		
3		

TITLE
SITE PLAN

JOB NO. XX-XX	SHEET NUMBER 
DRAWN : —	A1.0 OF SHEETS
CHECKED : —	
DATE : 3/11/2014	

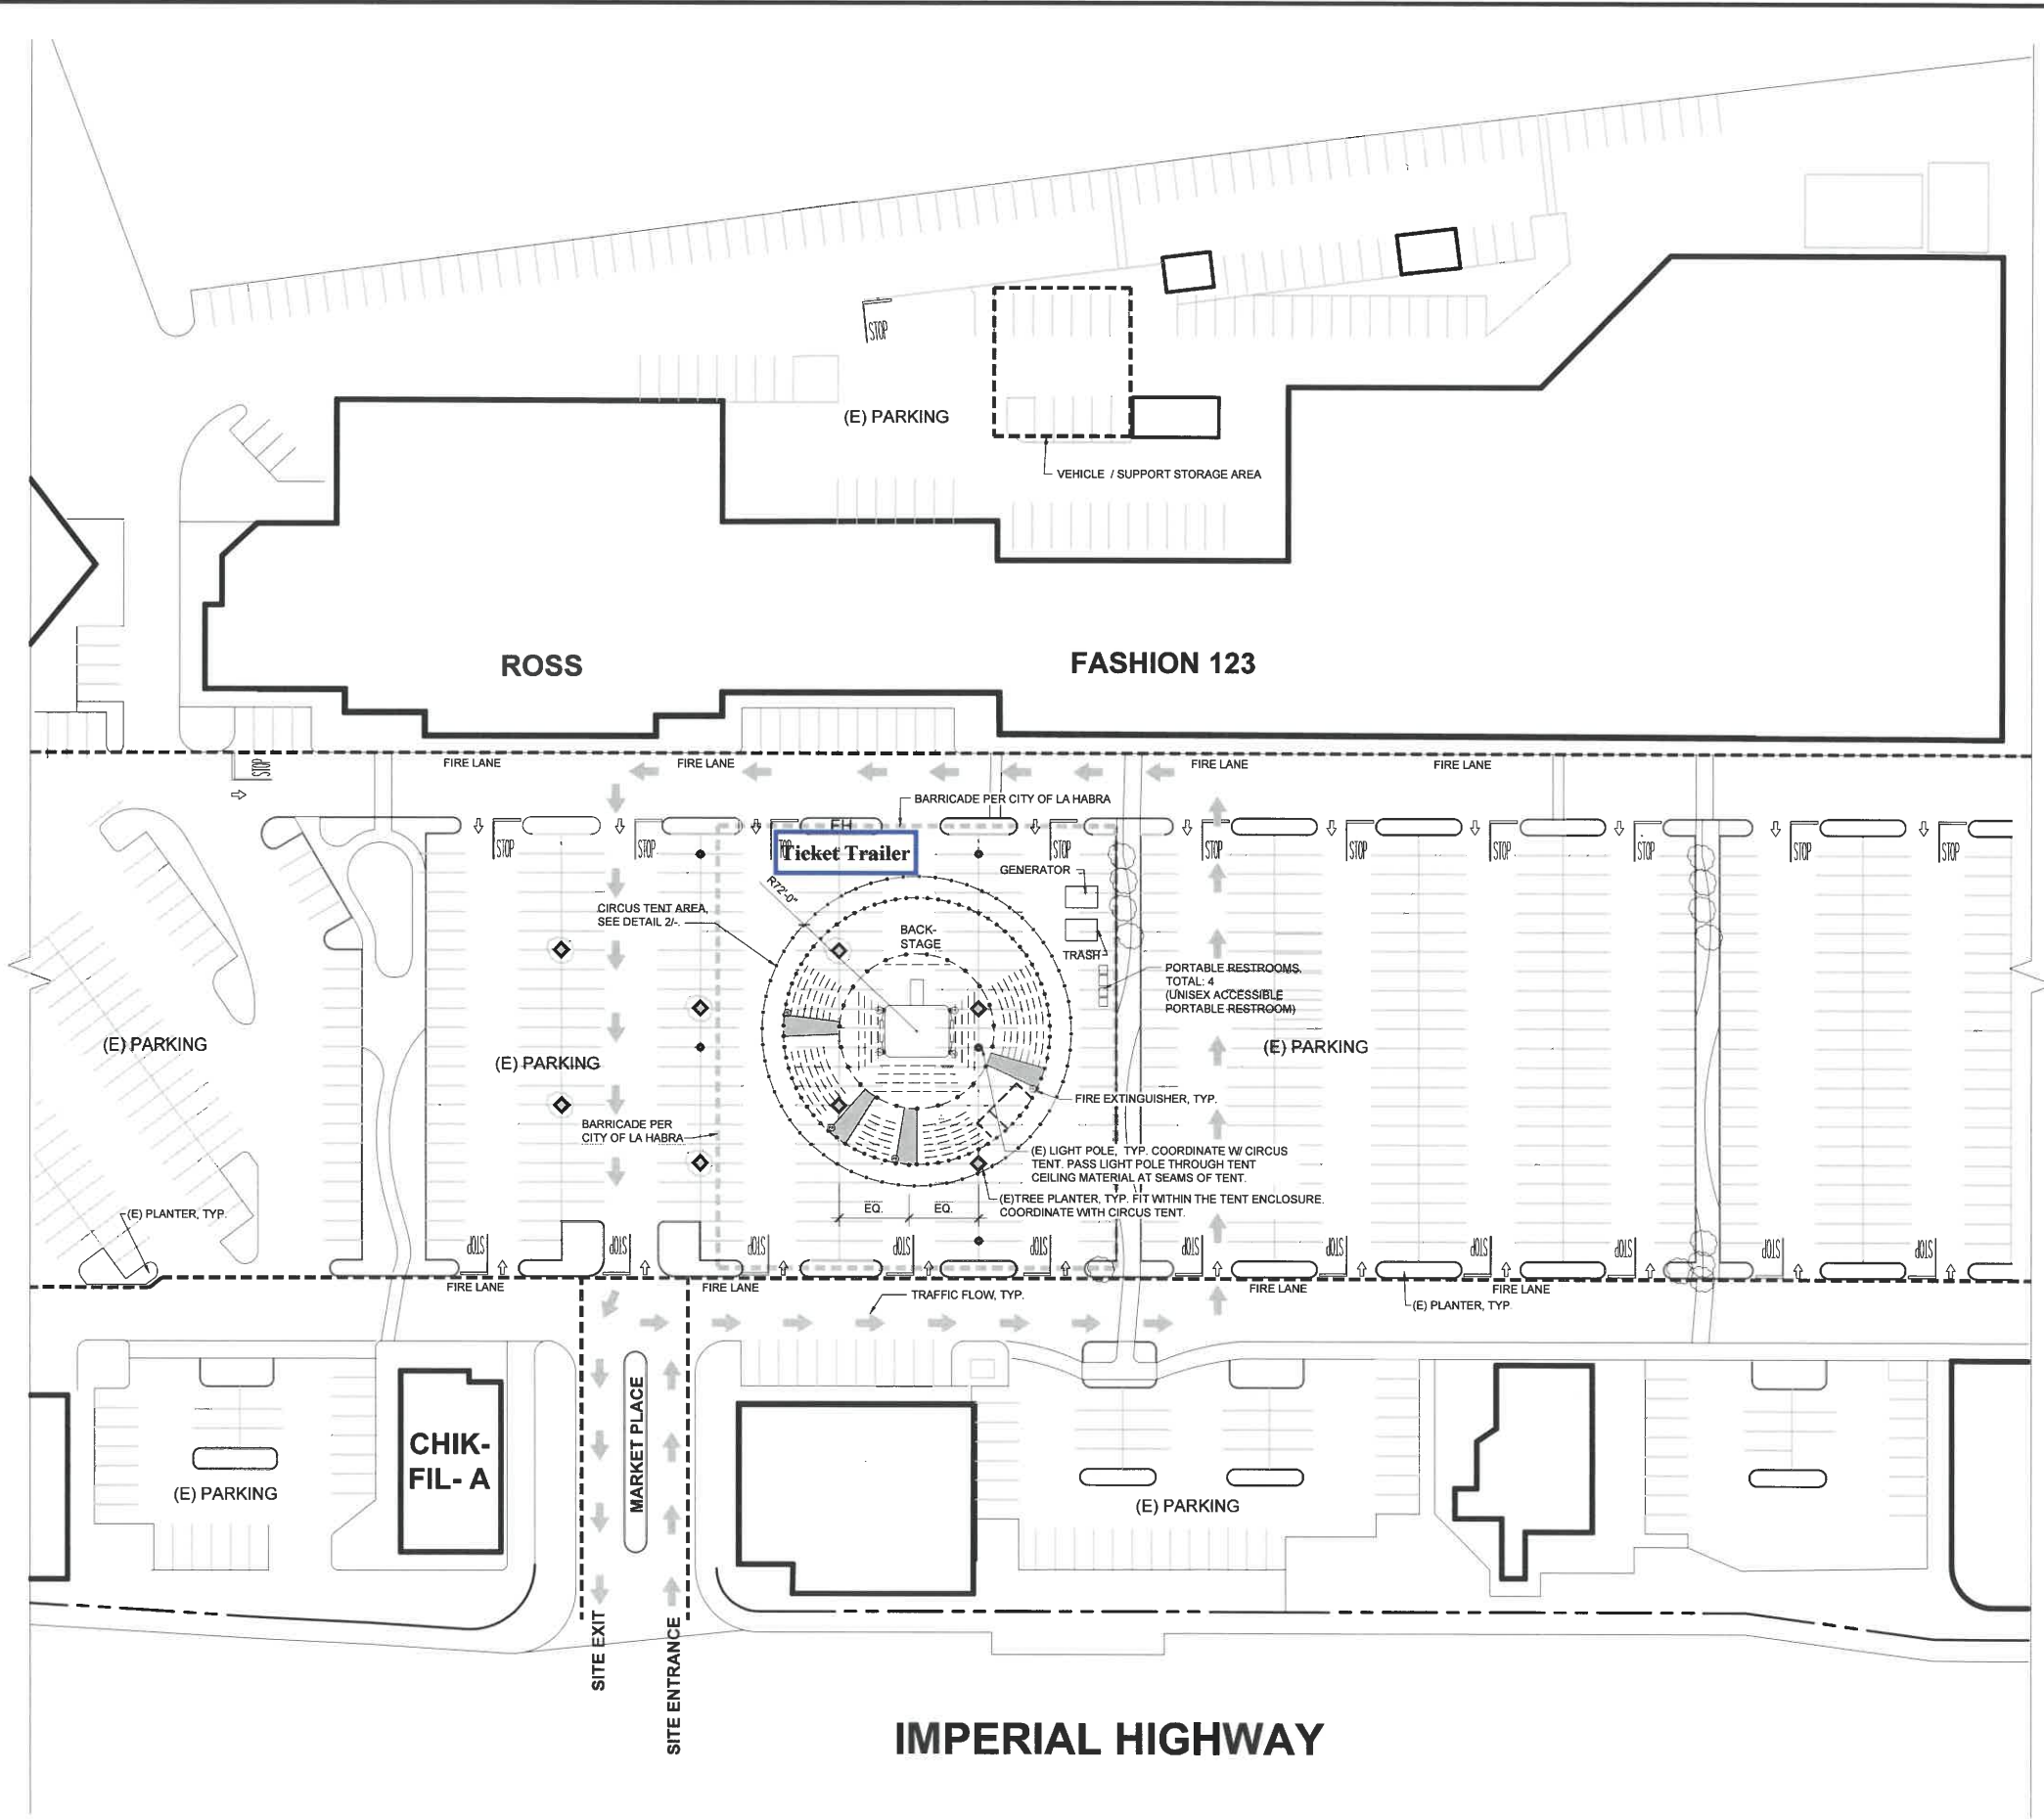


ACCESSIBILITY NOTE:
THE LOCATION WITHIN WHICH THE VENUE WILL BE HELD IS GENERALLY FLAT WITH MINIMAL LEVEL CHANGES WHICH SHOULD ACCOMMODATE PERSONS WITH DISABILITIES

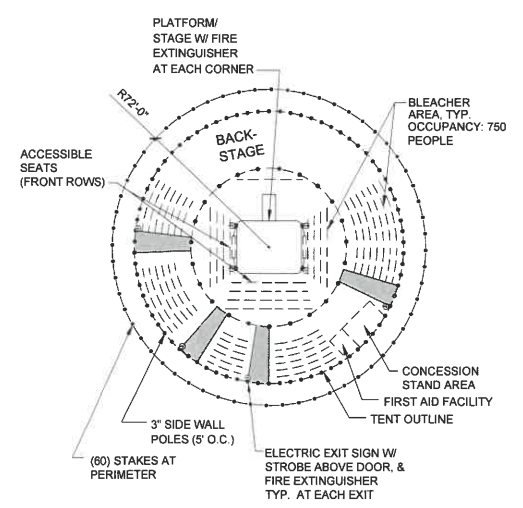

2 TENT AREA
Scale: 1"=40'-0"

1 SITE PLAN
Scale: 1"=40'-0"

Wednesday, July 30, 2014

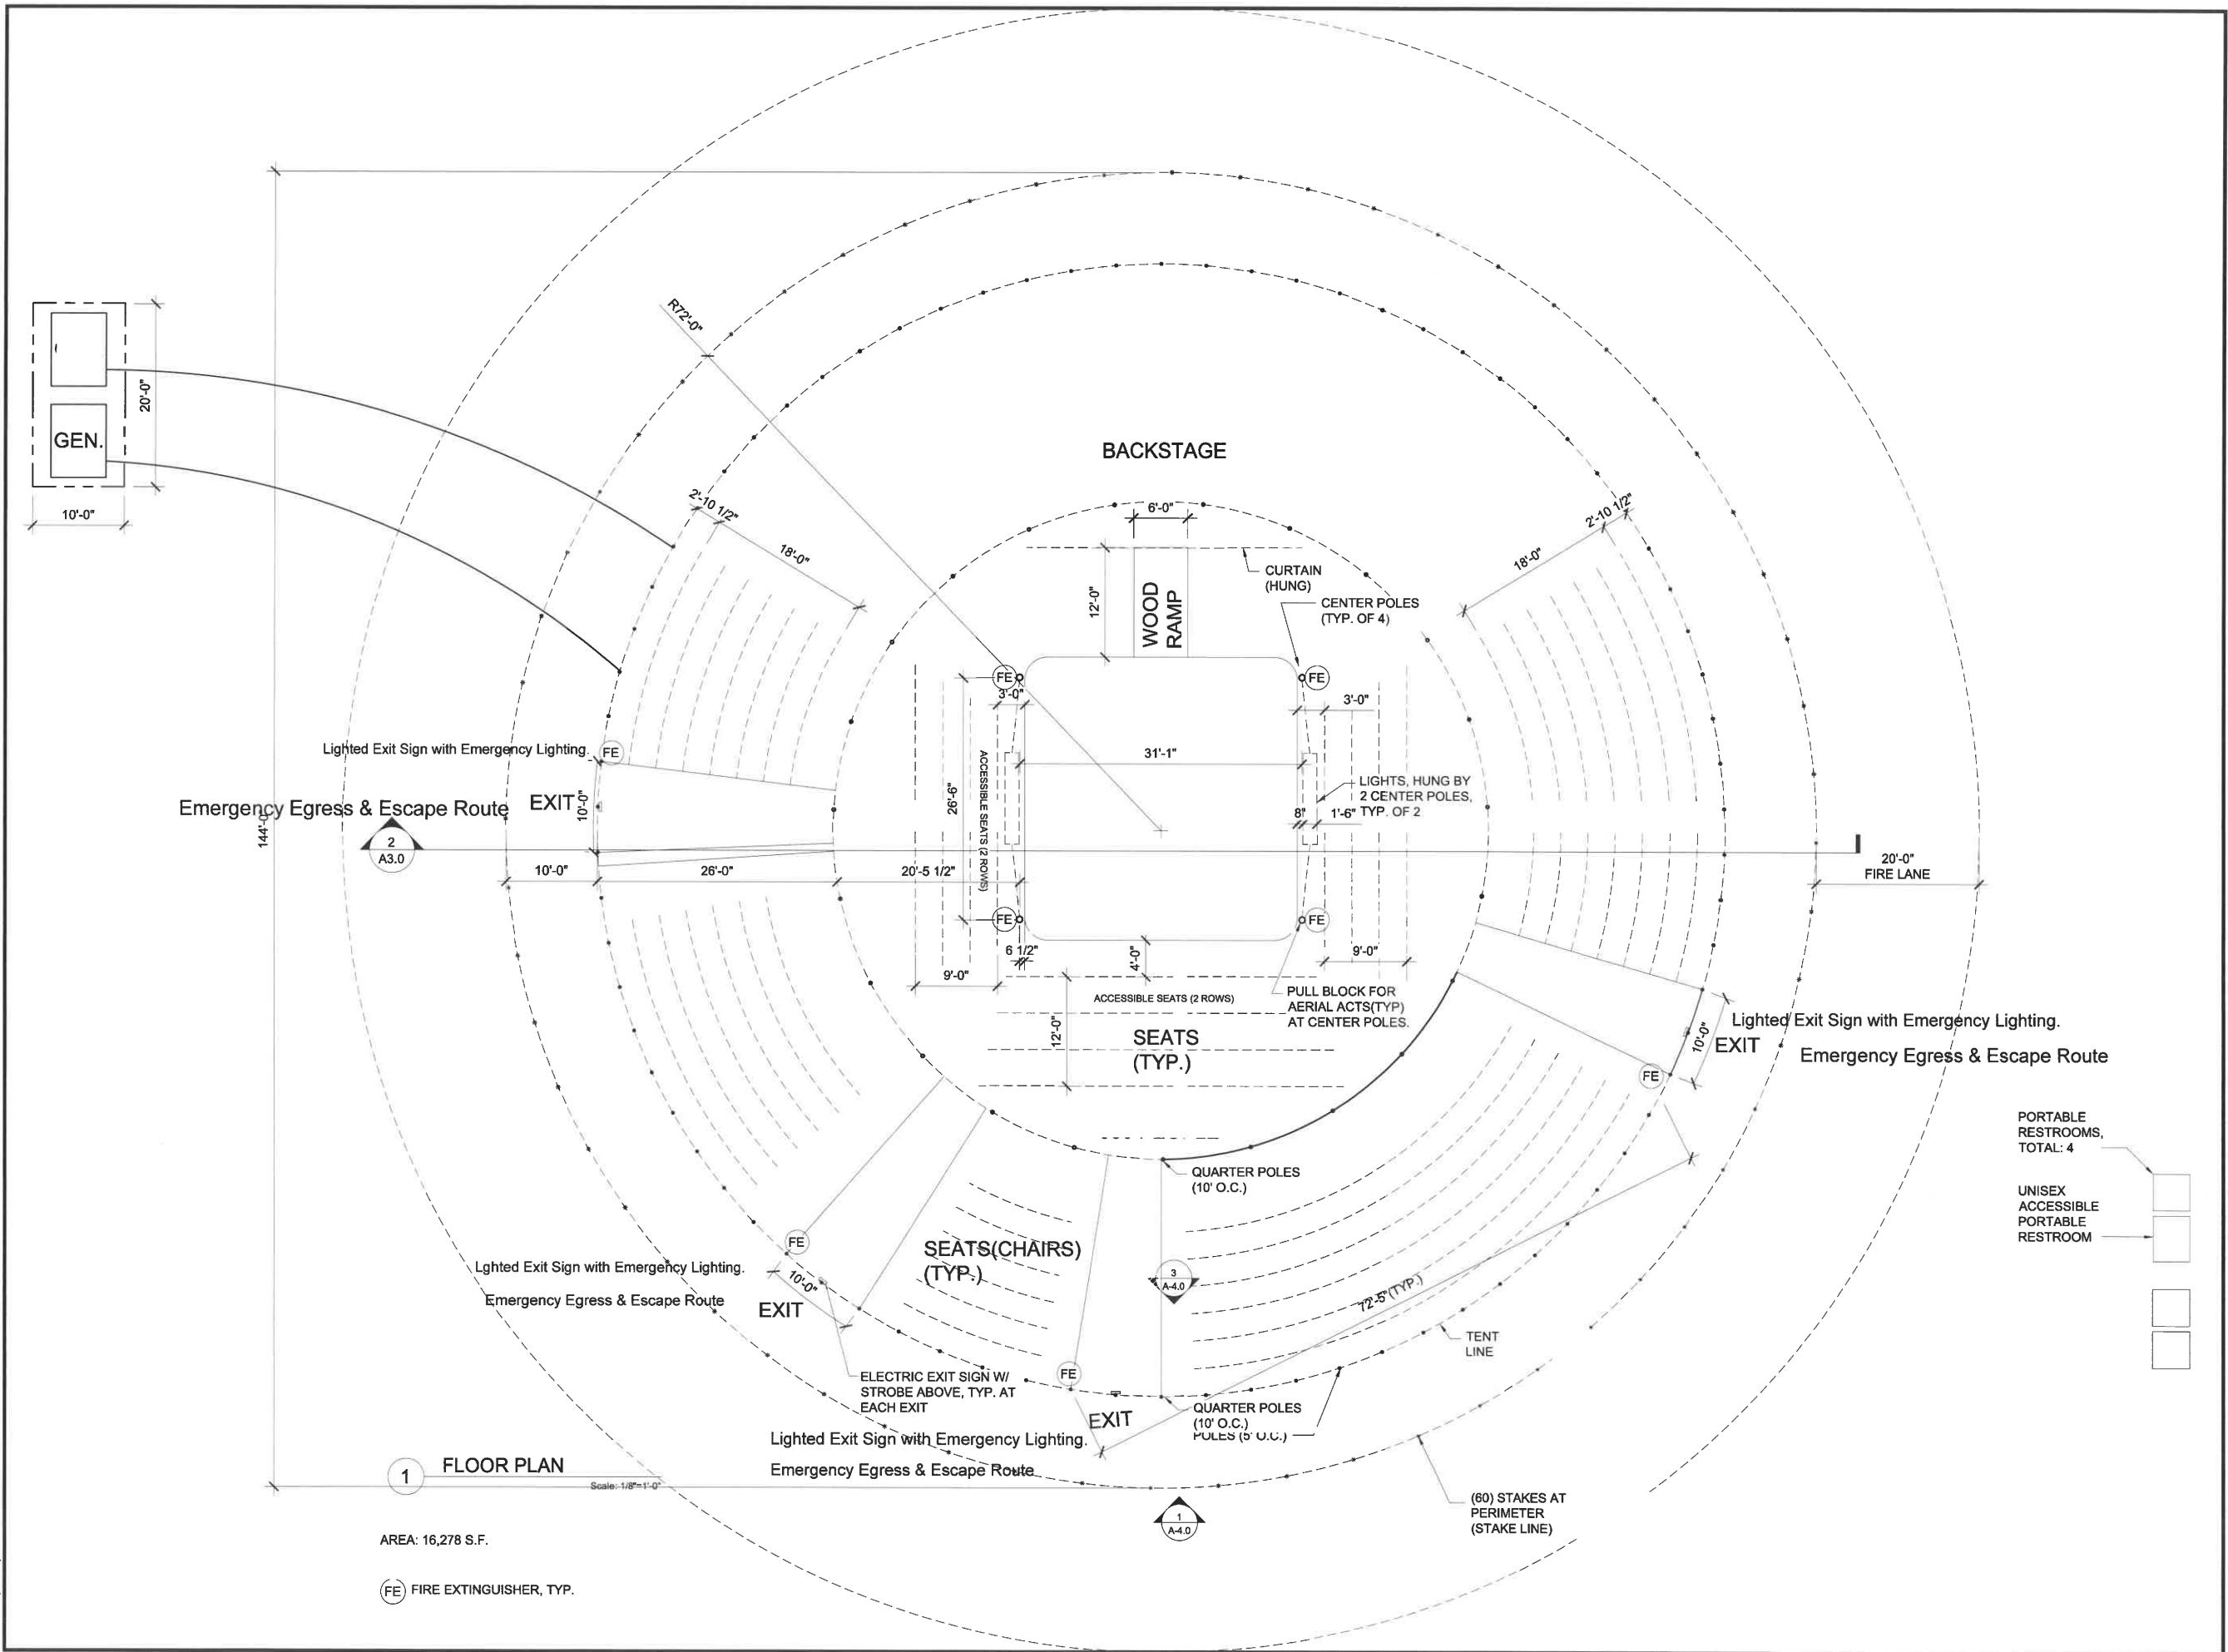

1 FLOOR PLAN
 AREA: 16,278 S.F.
 (FE) FIRE EXTINGUISHER, TYP.

- PORTABLE RESTROOMS, TOTAL: 4
- UNISEX ACCESSIBLE PORTABLE RESTROOM

PROJECT:
AMERICAN CROWN CIRCUS
AS BUILT
 PROJECT ADDRESS:
 LOS ANGELES COUNTY, CA

MARK	DATE	REVISIONS
1	MAY 2014	
2		
3		

TITLE
FLOOR PLAN

JOB NO.
13-1100
 DRAWN :
JG
 CHECKED :
MG
 DATE :
08 MAY 13

SHEET NUMBER
A2.0
 OF SHEETS